


T. 2S. R. 38E. W.M.

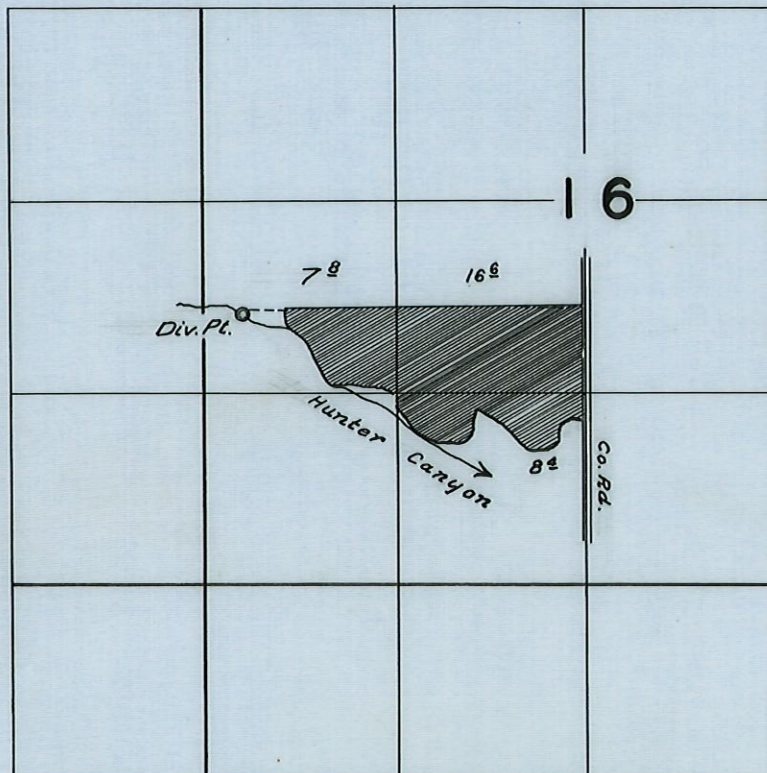

FINAL PROOF SURVEY
UNDER

Application No. 26257... Permit No. 20609...
IN NAME OF

Elmer E. McCoy

Surveyed Aug. 7, 1959, by R.H. Jackson.