


T. 13S. R. 1E. W.M.

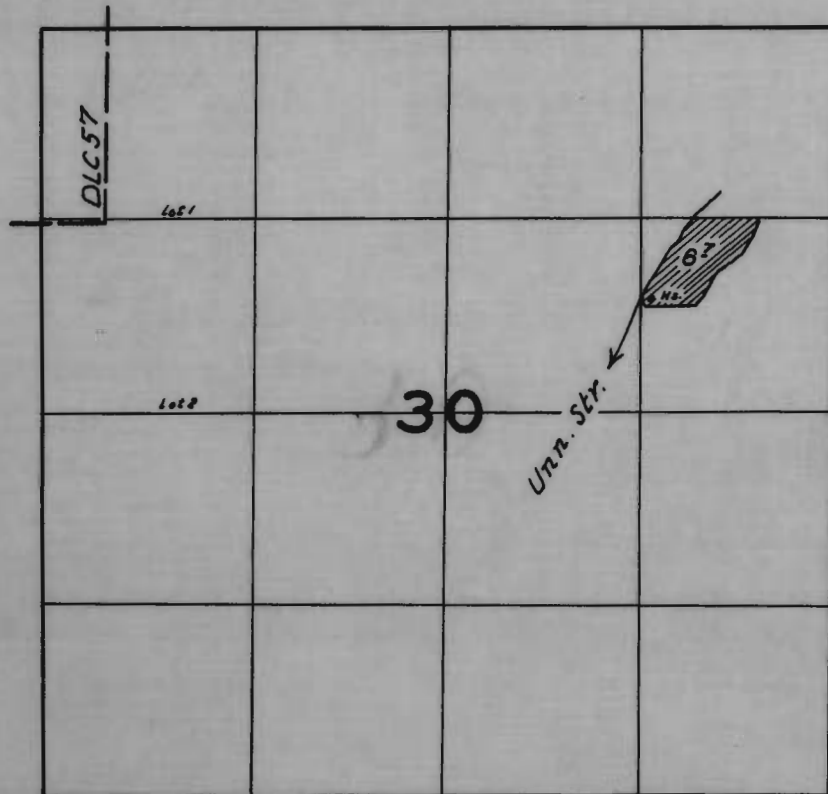

FINAL PROOF SURVEY
UNDER

Application No. 26376 Permit No. 20696

IN NAME OF

J. R. Christiansen

Surveyed Aug. 31 1959, by R. H. Jackson