


T. 12S. R. 1E. W.M.

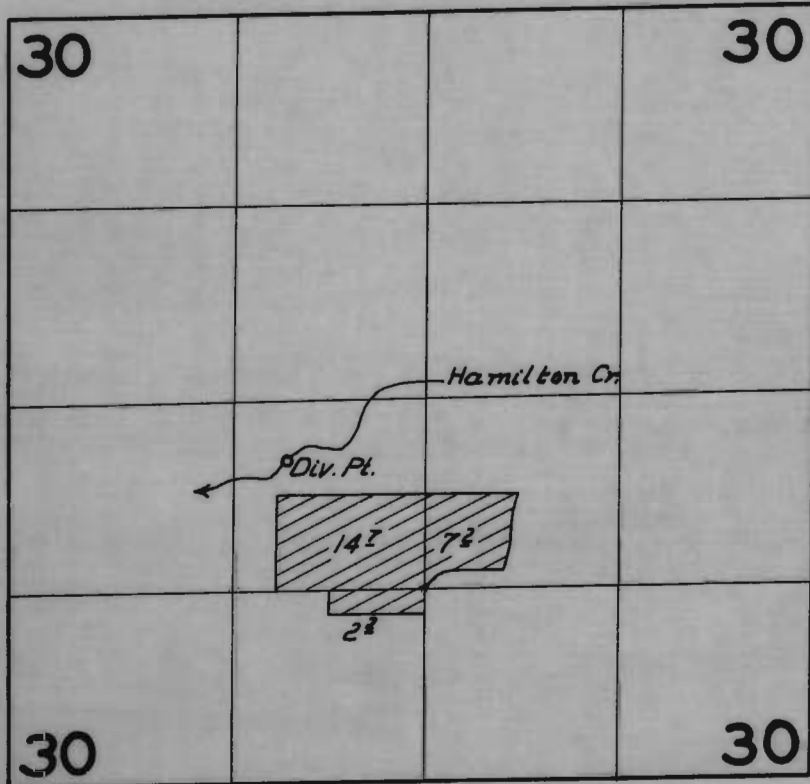

FINAL PROOF SURVEY

UNDER

Application No. 26377 Permit No. 20697

IN NAME OF

*Gloyd E. Adams*

Surveyed *Aug. 31 19 59.*, by *R. H. Jackson*