


T. 3N. R. 10W. W.M.

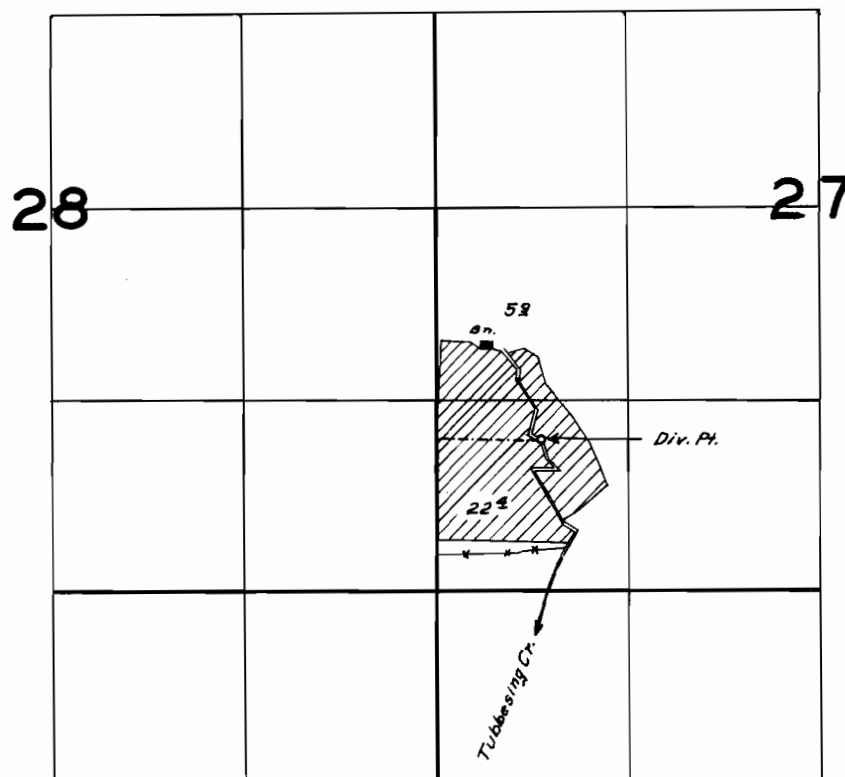

FINAL PROOF SURVEY
UNDER

Application No. 26898... Permit No. 21136...
IN NAME OF

Loretto Rasmussen

Surveyed April 14 1959, by R.H. Jackson...