
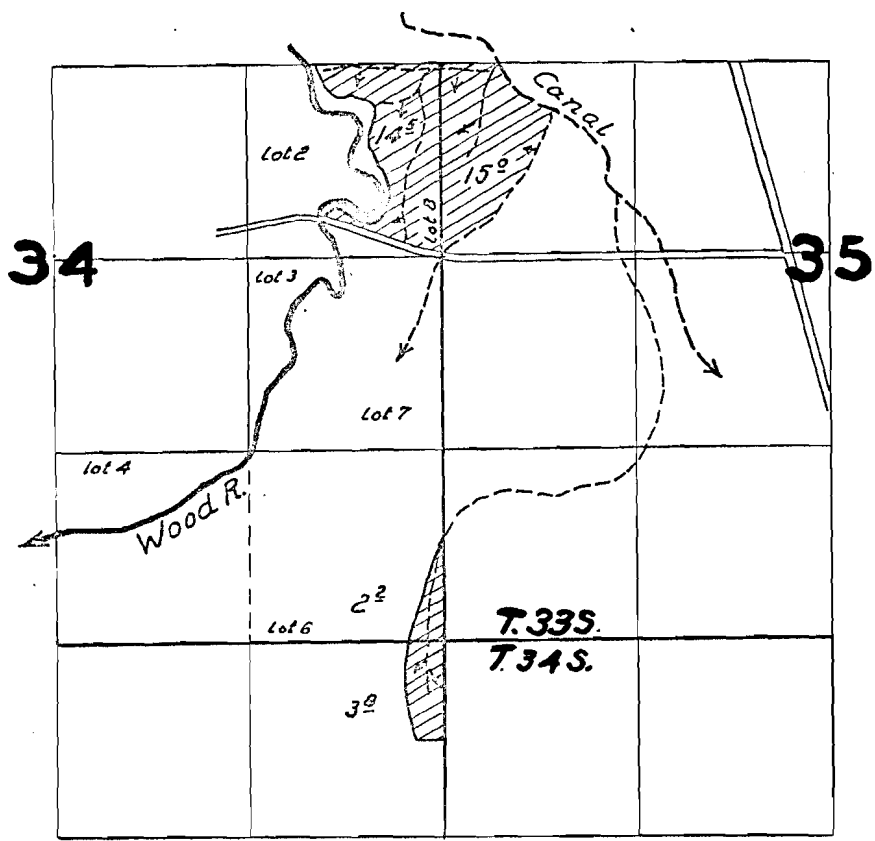


# T. 33&34S. R. 7 1/2E. WM.

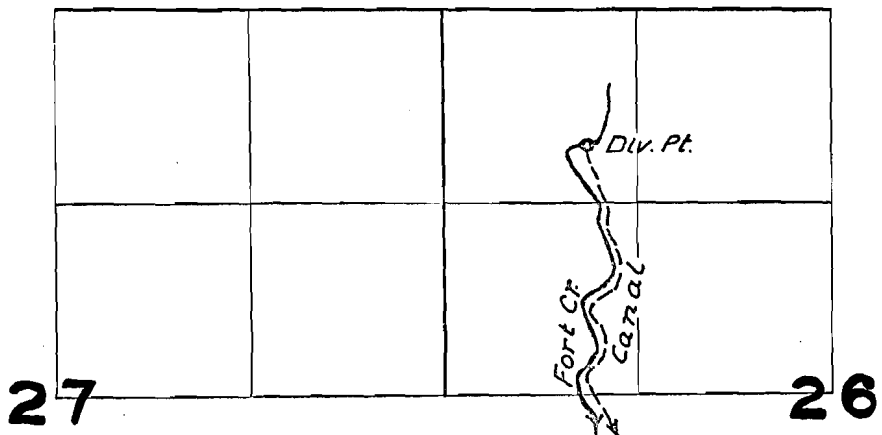

## FINAL PROOF SURVEY UNDER

Application No. 26994... Permit No. 21203.....  
IN NAME OF

J. L. Helms

Surveyed Oct. 15... 19.59, by R. H. Jackson...

Crooked Creek map.