


T. 2 S. R. 4 W. W. M.

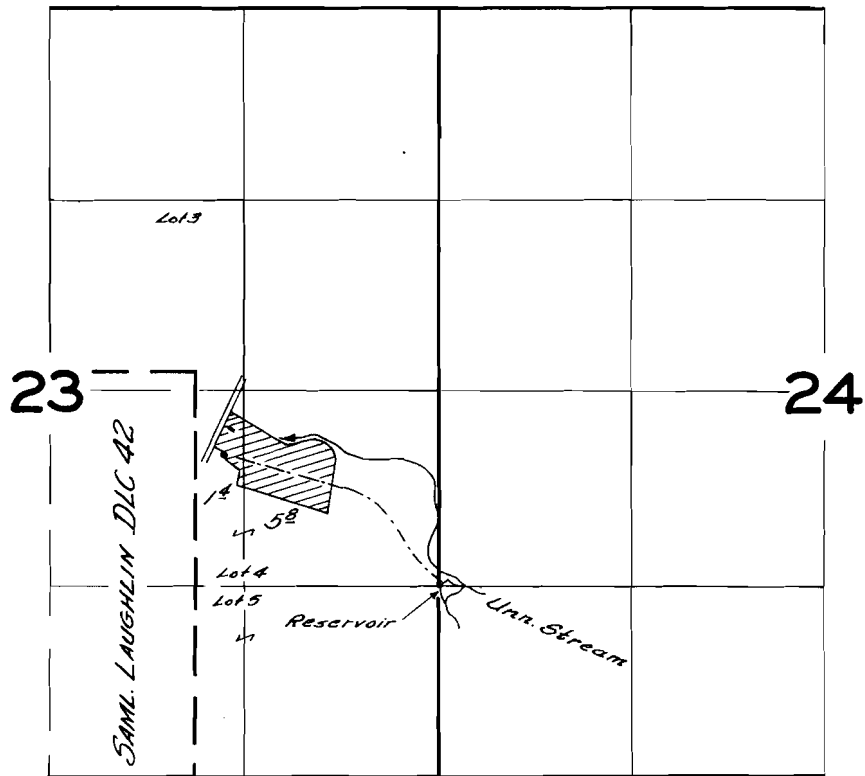

FINAL PROOF SURVEY
UNDER

Application No. R-27793 27794 Permit No. R-1436 21820
IN NAME OF

L. W. & MARTHA NAIL

Surveyed MAY 9 1958, by M. BISH