


T. 2 S. R. 4 W. W. M.

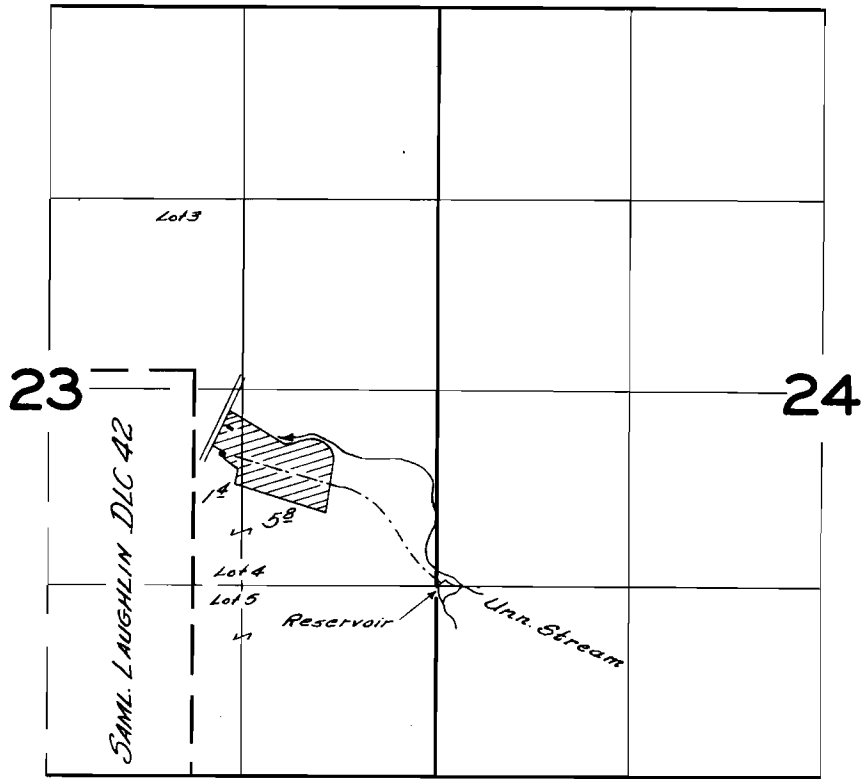

**FINAL PROOF SURVEY**  
UNDER

Application No. R-27793 27794 Permit No. R-1436 21820  
IN NAME OF

LEE W. & MARTHA NAIL

Surveyed MAY 9 1958, by M. BISH