


T.11S.R.4W.W.M.

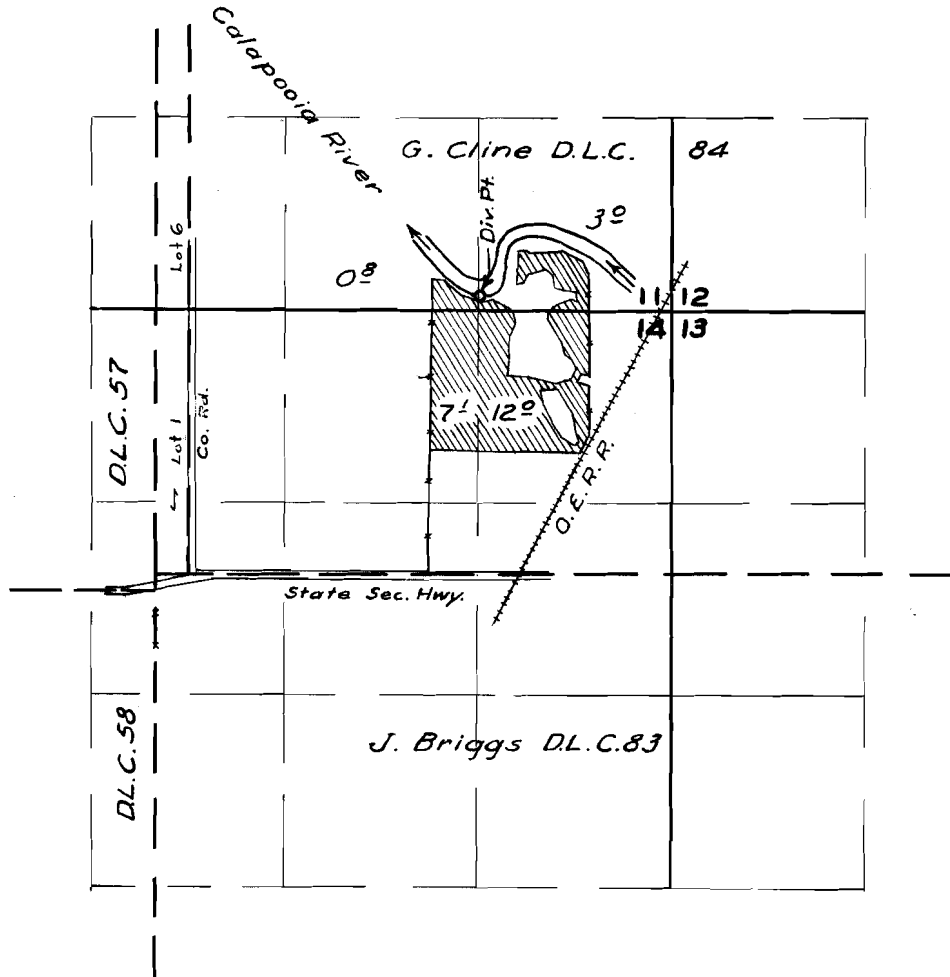

FINAL PROOF SURVEY UNDER

Application No. 27869 Permit No. 21956
IN NAME OF

W. H. BOTTEMILLER

Surveyed 28 July 1959, by *M. Bish*