


T. 1N. R. 39E. W.M.

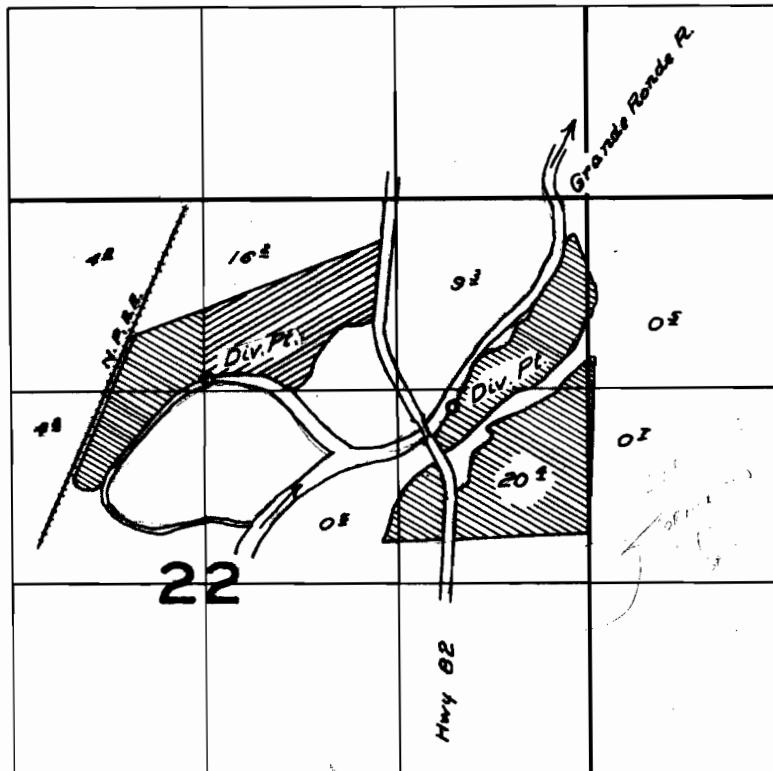

FINAL PROOF SURVEY
UNDER

Application No. 28012..... Permit No. 22047.....
IN NAME OF

F.L. & Ella M. Ralston.....

Surveyed Aug. 4, 1959, by R.H. Jackson.....