


T. 2S. R. 2W. W.M.

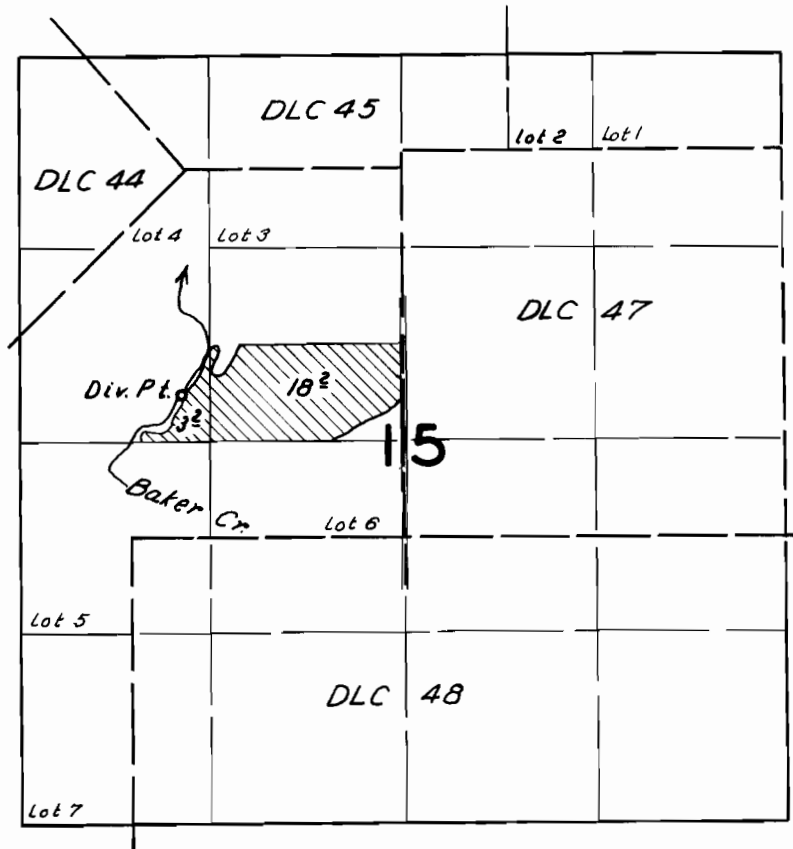

FINAL PROOF SURVEY
UNDER

Application No. 28294. Permit No. 22246.
IN NAME OF

..... *Earl O. Christopherson*

Surveyed Nov. 5, 1959, by *C.O. Bartels*