


T. 5S. R. 2W. W.M.

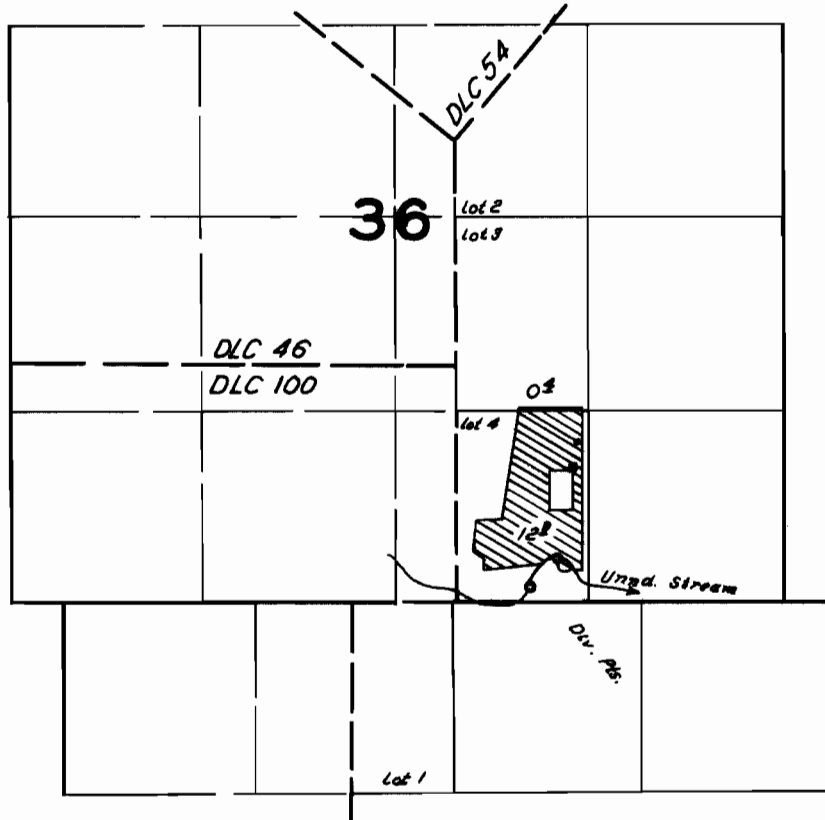

FINAL PROOF SURVEY
UNDER

Application No. 28551 Permit No. 22332
IN NAME OF

Robert W. Graves

Surveyed May 21 1959, by R. H. Jackson.