


T.39 S. R.5 W.W.M.

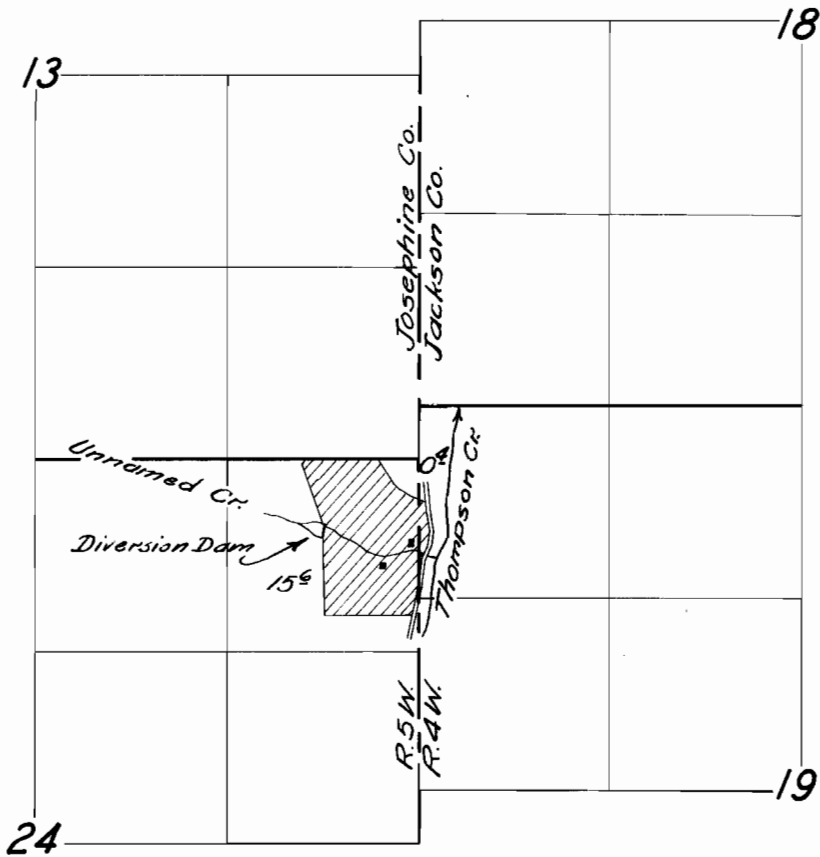

FINAL PROOF SURVEY

UNDER

Application No. 28396 Permit No. 22402

IN NAME OF

FRANK DECKER

Surveyed July 24, 1959 by COBARTS