


T. 13S. R. 4W. WM

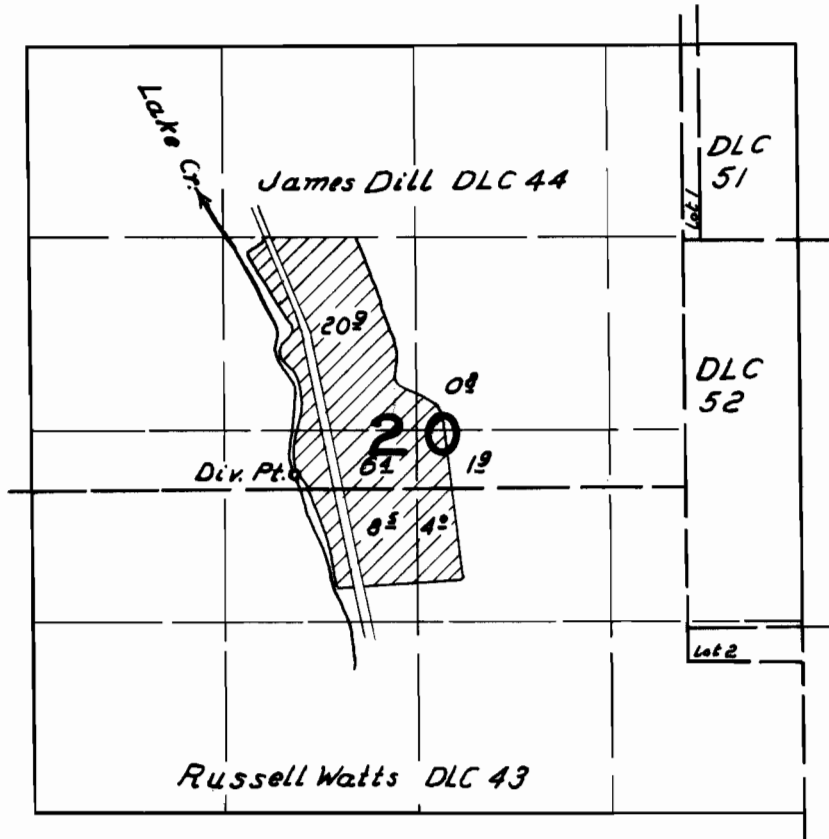

FINAL PROOF SURVEY

UNDER

Application No. 28163 Permit No. 22438

IN NAME OF

Archie R. & Hilda May Hilbert

Surveyed Aug. 26 1959, by R.H. Jackson