


T.12 S.R.6 W.W.M.

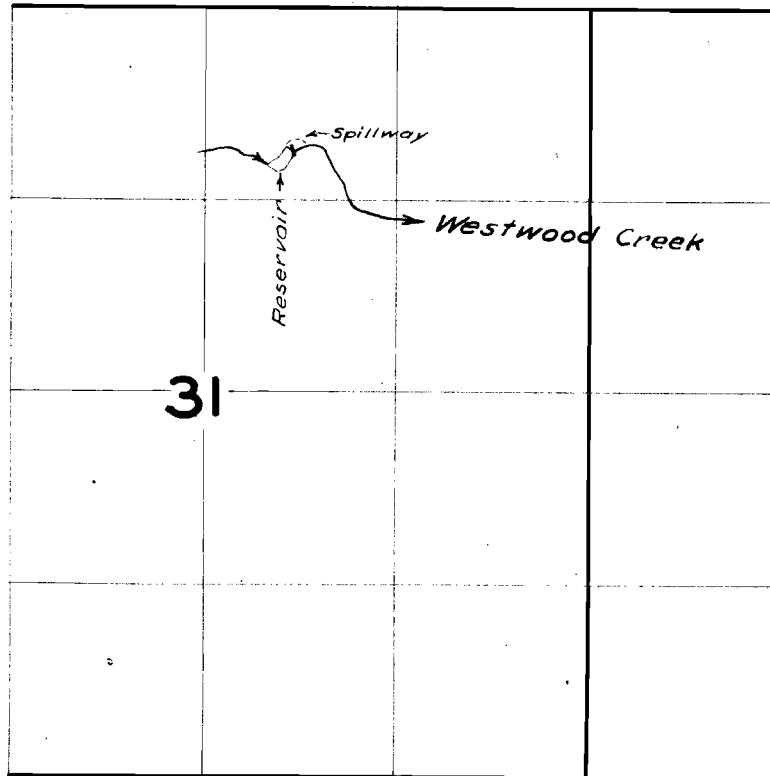

FINAL PROOF SURVEY
UNDER

Application No. ²⁸⁵⁰³ ~~R-27744~~ Permit No. ²²⁴⁶⁷ ~~R-1514~~
IN NAME OF

T. J. STARKER

Surveyed 16 Mar. 1959, by m. Bish