
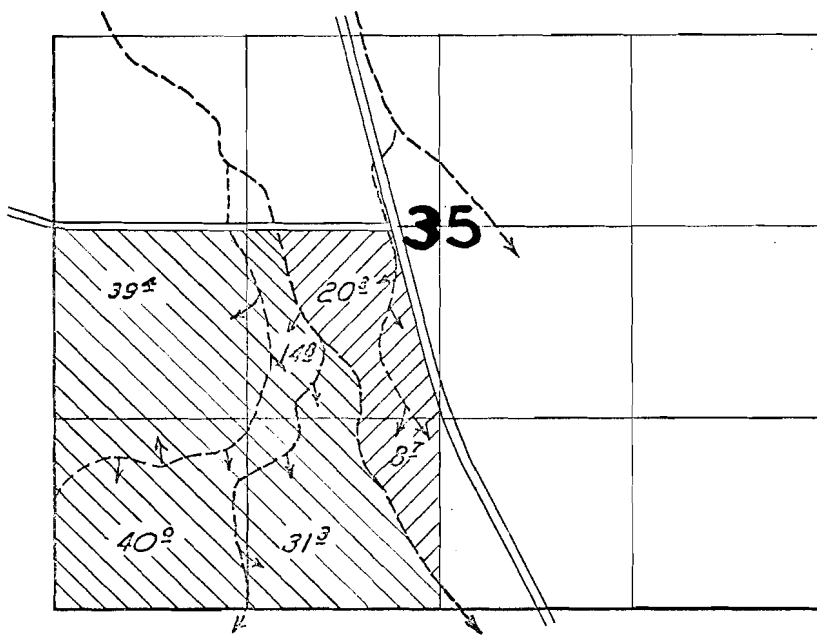


T. 33S. R. 7 1/2E. W.M.

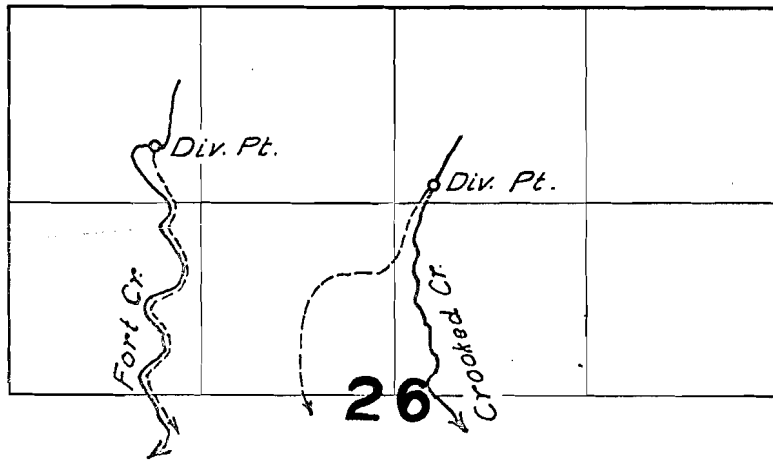

Fort Cr. Water Crooked Cr. Water

FINAL PROOF SURVEY

UNDER

Application No. 28554. Permit No. 22512

IN FAVOR OF

Fred L. Pope Jr.

Surveyed May 7 1958, by C.O. Bartels.
 Oct. 15 1959, by R.H. Jackson.

Crooked Cr. & misc.