


22671

T.1N. R.13E.W.M.

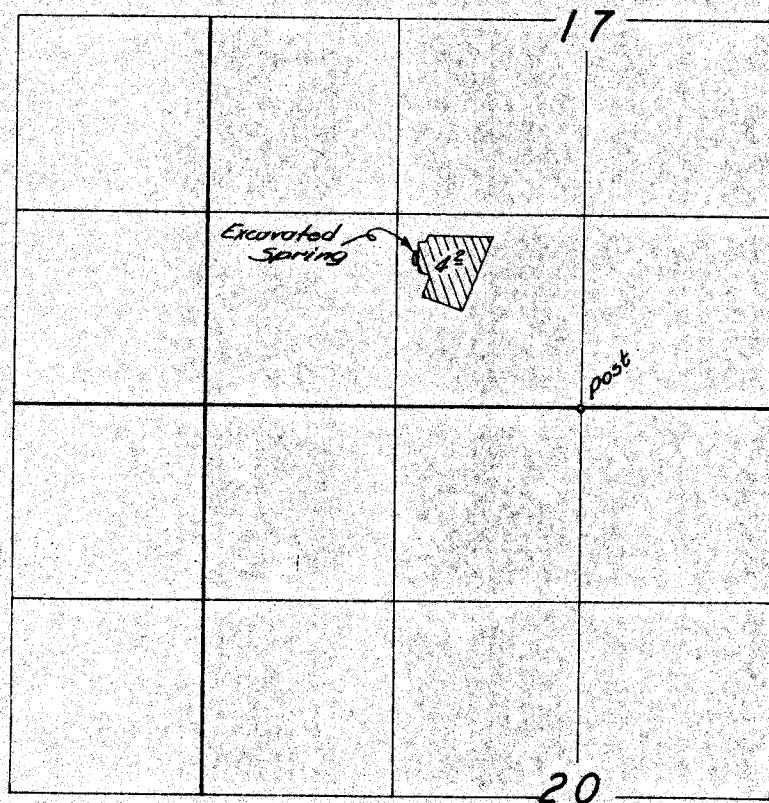

FINAL PROOF SURVEY

UNDER

Application No. 28806. Permit No. 22671

IN NAME OF

C. E. & Adeline G. Anderson

Surveyed Nov. 14, 1959, by C. D. Smith