


T. 1 S. R. 4 E. W.M.

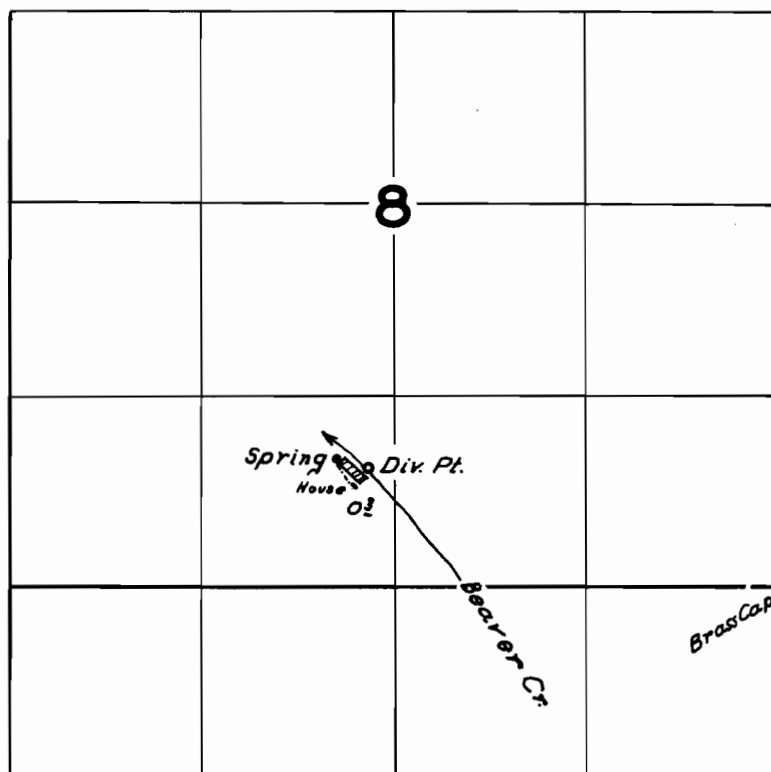

FINAL PROOF SURVEY
UNDER

Application No. 28870 Permit No. 22703
IN NAME OF

Vernon W. Wasson

Surveyed June 3 1959, by C.O. Bartels

1959 *HL*