


T.32 S.R.5 W.W.M.

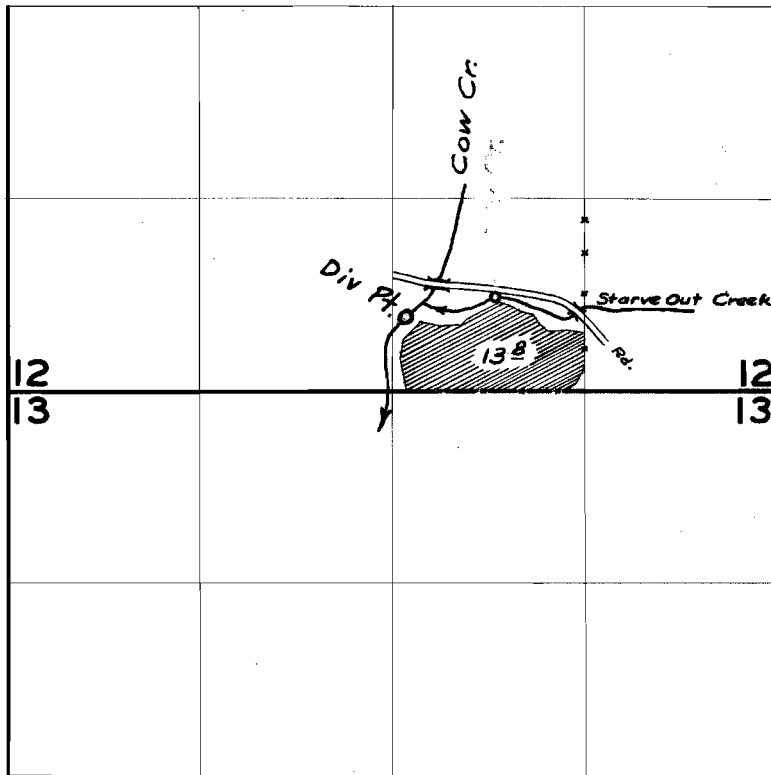

FINAL PROOF SURVEY
UNDER

Application No. 29260 Permit No. 23012
IN NAME OF

O. H. CLARK

Surveyed 8 Sept. 1958, by M. Bish