


T. 39 S. R. 20 E. W.M.

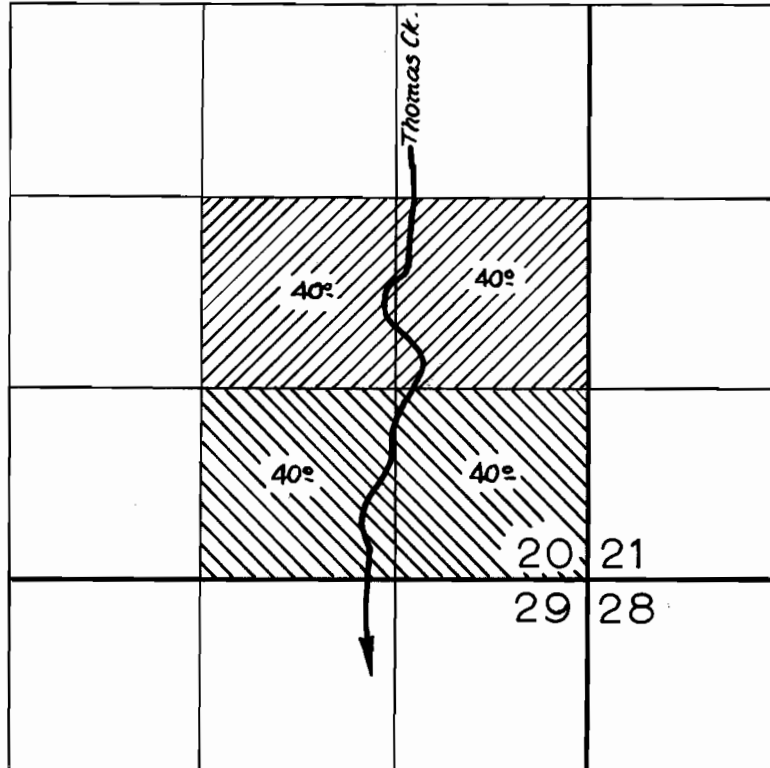

29381

29380



FINAL PROOF SURVEY
UNDER

Application No. ²⁹³⁸⁰ 29381 Permit No. ²³¹⁴⁷ 23148
IN NAME OF

LINDA & ROSS E. DUKE JR. - WAYLAND PIERSON

Surveyed May 7, 1959, by *RH Jackson*