


T. 2S. R. 2W. W.M.

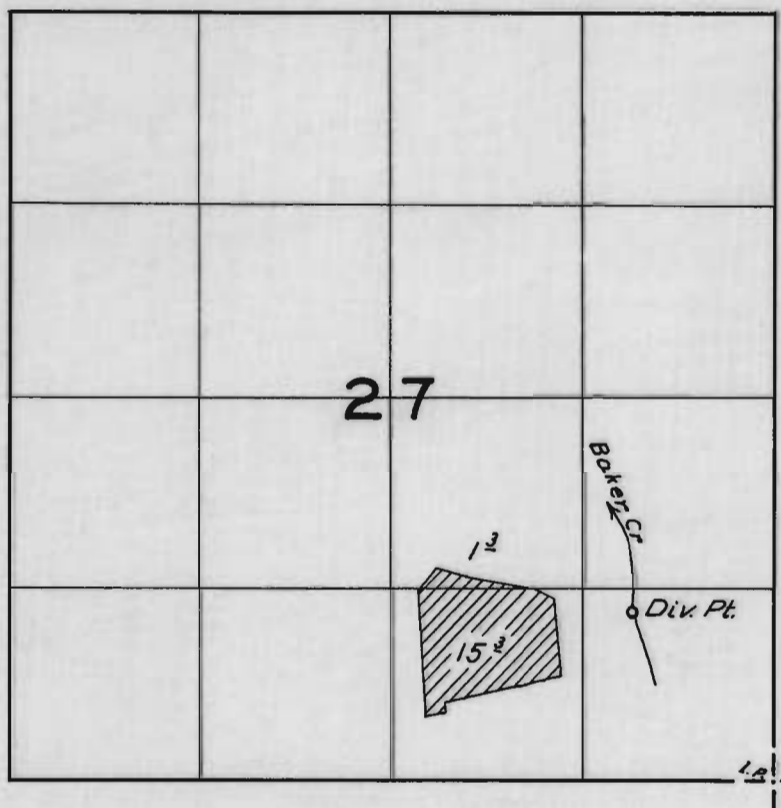

FINAL PROOF SURVEY

UNDER

Application No. 29135 Permit No. 23234

IN NAME OF

Peters Brothers

Surveyed Nov 6 1959, by C.O. Bartels