


T 32S. R. 7E. WM.

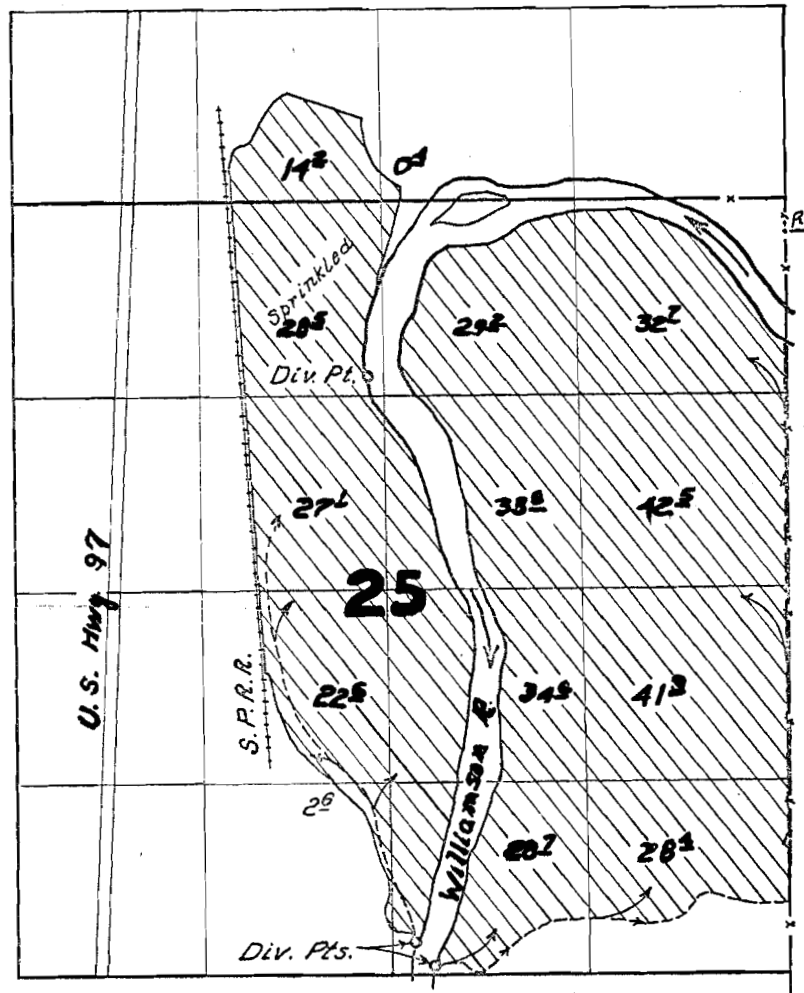

Williamson River

MINAL PROOF SURVEY

UNDER

Application No. 29801... Permit No. 23453.....

IN NAME OF

Ray O. & Alice M. Hobbs.....

Surveyed Oct. 24 1959... by R.H. Jackson....