


T. 2S. R. 1W. W.M.

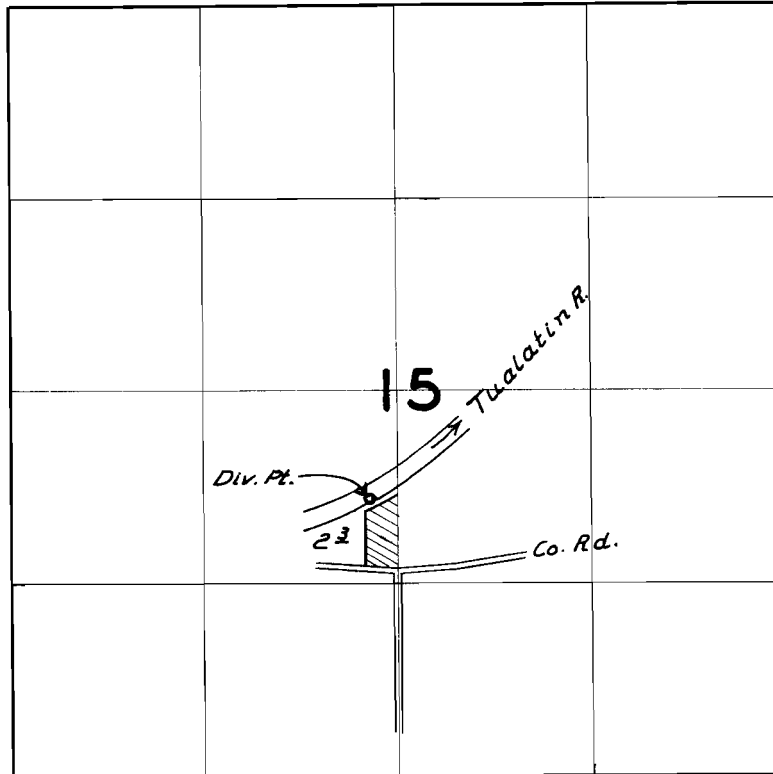

FINAL PROOF SURVEY
UNDER

Application No. 29872 Permit No. 23528
IN NAME OF

..... *Harry L. & Nellie E. Clark*

Surveyed *Sept. 14 1959*, by *C.O. Bartels*


DFR-10-35