


T. 1N. R. 39E. W.M.

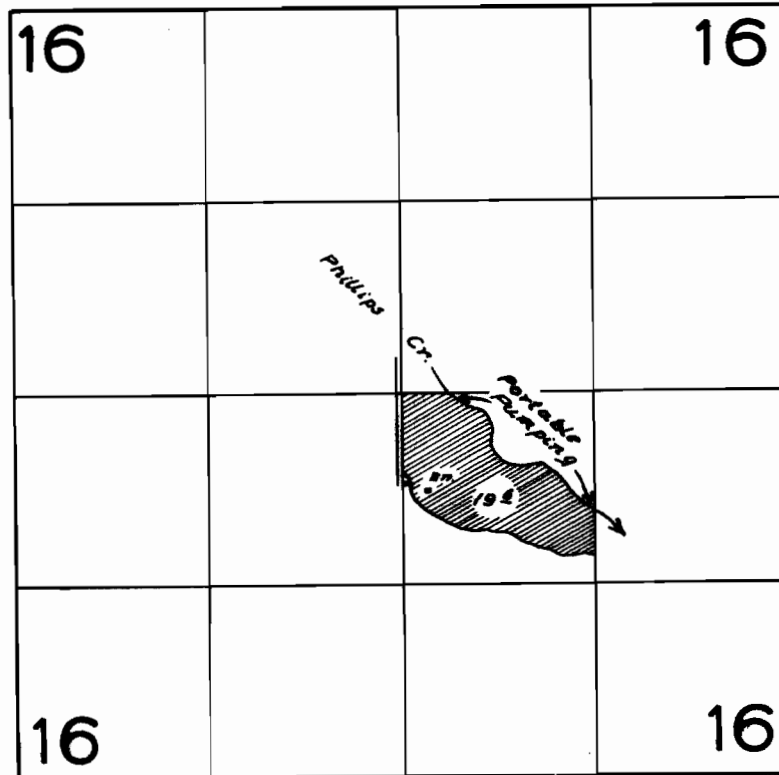

FINAL PROOF SURVEY
UNDER

Application No. 29462 Permit No. 23672
IN NAME OF

Evert R. Arbogast

Surveyed Aug. 18, 1959, by R. H. Jackson