


T. 35S. R. 5W.W.M.

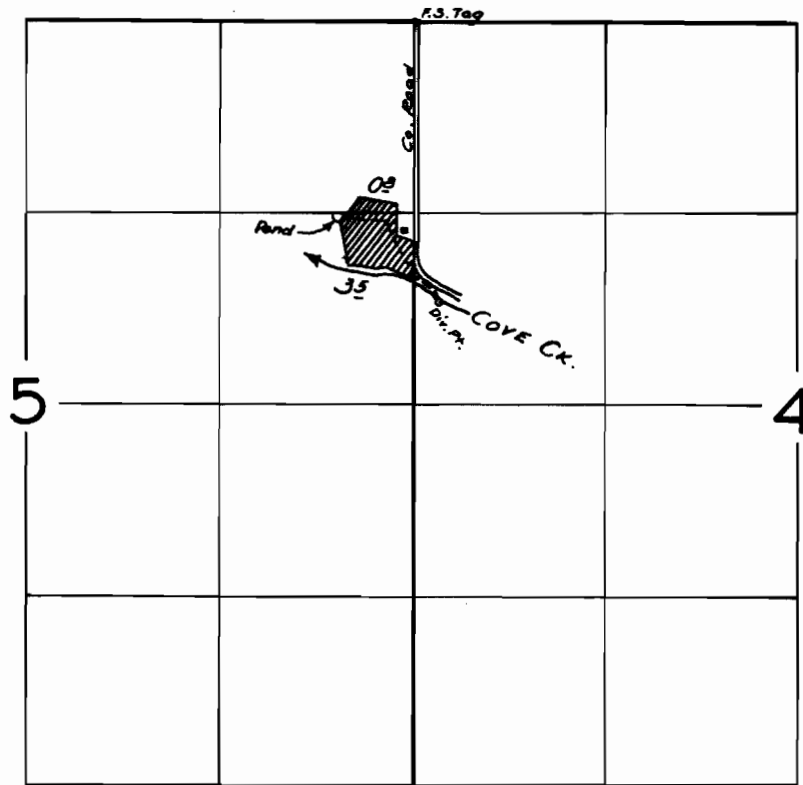

**FINAL PROOF SURVEY**  
UNDER

Application No. 30070. Permit No. 23700.  
IN NAME OF

*JOSEPH E. POLLOCK*

Surveyed July 25, 1959, by *R. Jackson*