


T. I. S. R. 39E. W.M.

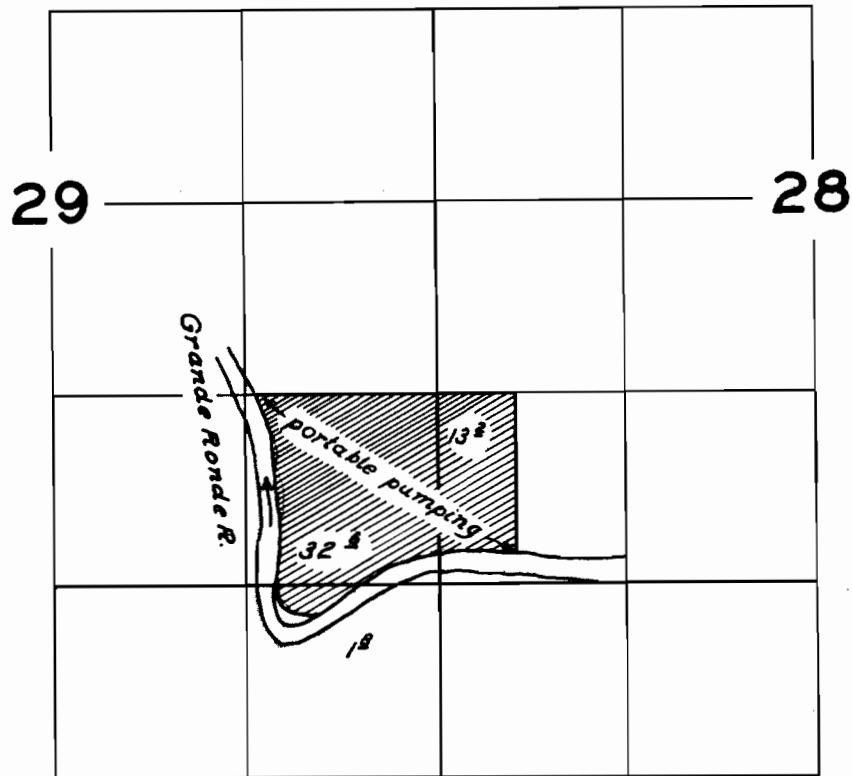

FINAL PROOF SURVEY
UNDER

Application No. *30122* Permit No. *23774*
IN NAME OF

P. C. Westenskow

Surveyed *Aug. 6,* 1959, by *R.H. Jackson*