


T. 34S.R. 6 W.W.M.

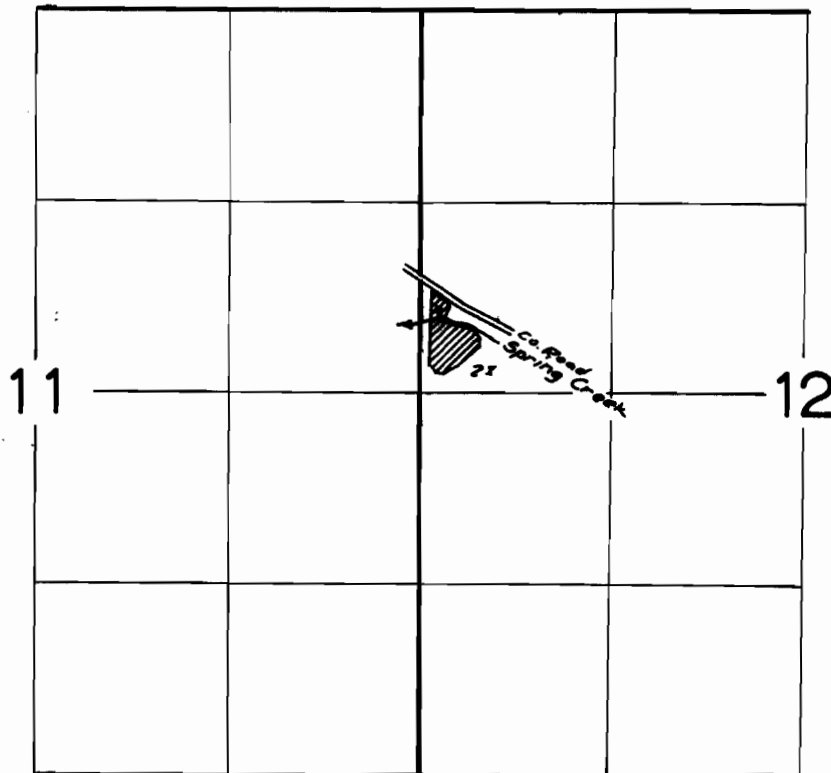

FINAL PROOF SURVEY
UNDER

Application No. 59212... Permit No. 23821...
IN NAME OF

..... *WILLIAM L. FOSTER*

Surveyed July 25, 1959, by *R.D. Jackson*