


T. 36S.R. 6W.W.M.

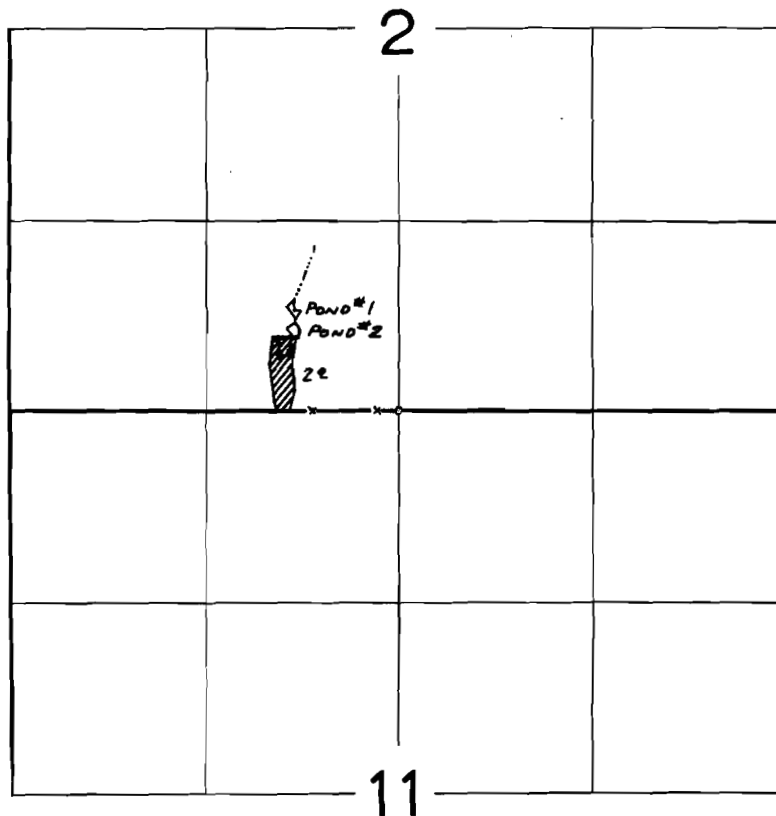

FINAL PROOF SURVEY
UNDER

Application No. 30416 Permit No. 23894
IN NAME OF

LILLIAN M. HARRIS

Surveyed July 25 1959, by *R. Jackson*