


T. 2S. R. 1W. W.M.

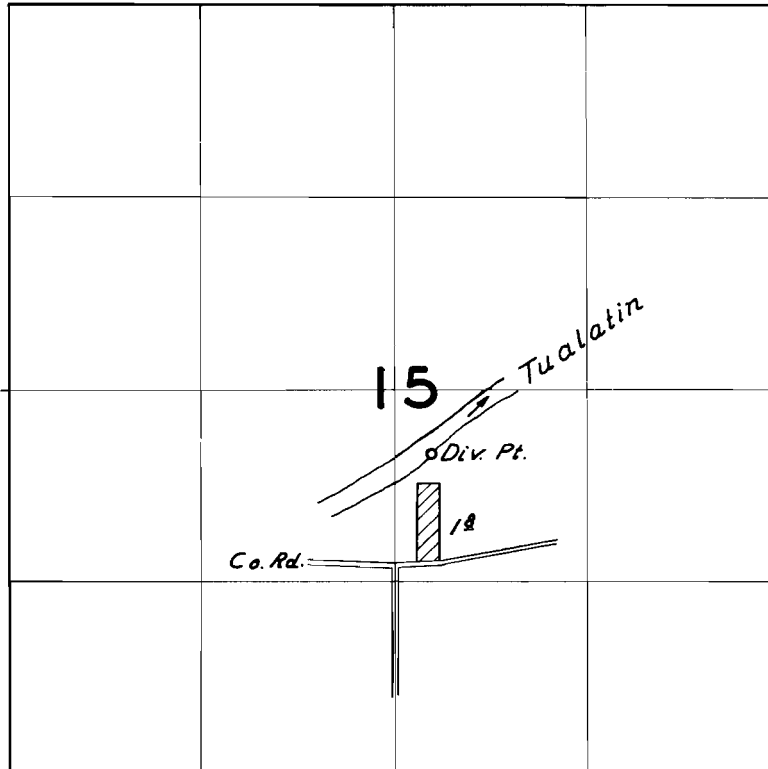

FINAL PROOF SURVEY
UNDER

Application No. 30557... Permit No. 24076...
IN NAME OF

..... *Chester O. Hopper*

Surveyed *Sept. 14 1959*, by *C. O. Bartels*...