


T. 2 S. R. 2 W. W.M.

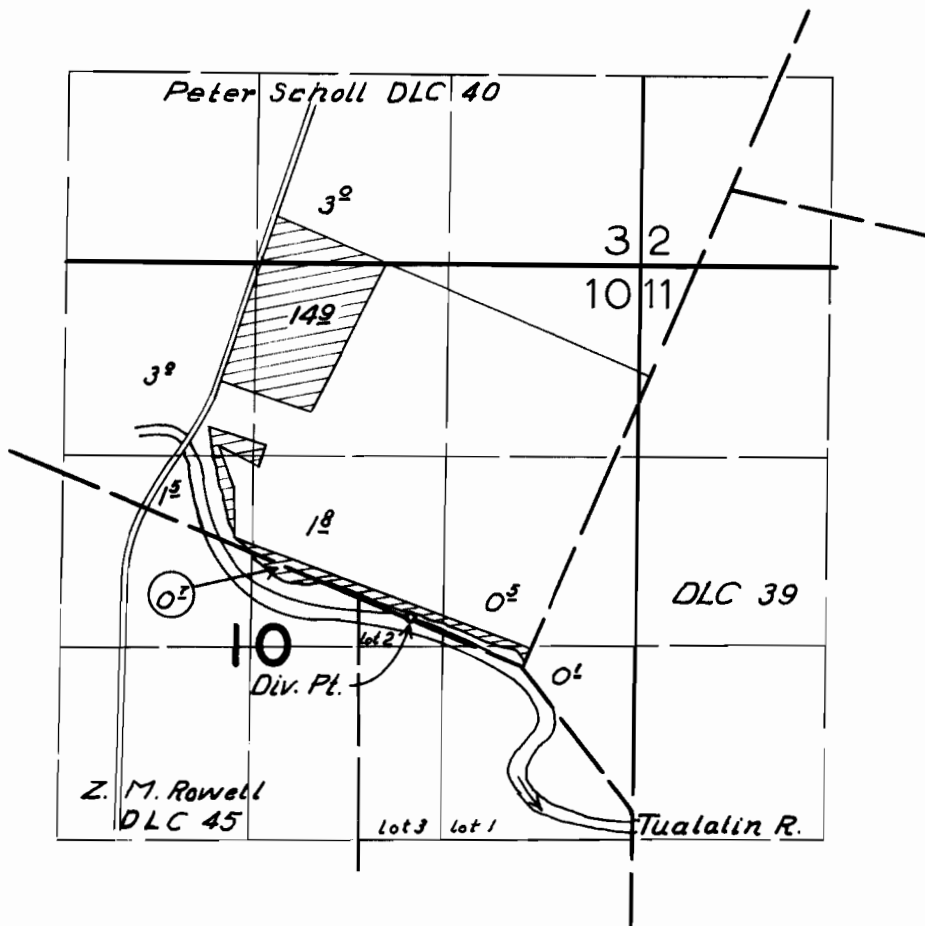

FINAL PROOF SURVEY

UNDER

Application No. 30690 Permit No. 24216

IN NAME OF

Bracey Neal

Surveyed Sept. 16 1959 by C. O. Bartels