


T. 2S. R. 1W. W.M.

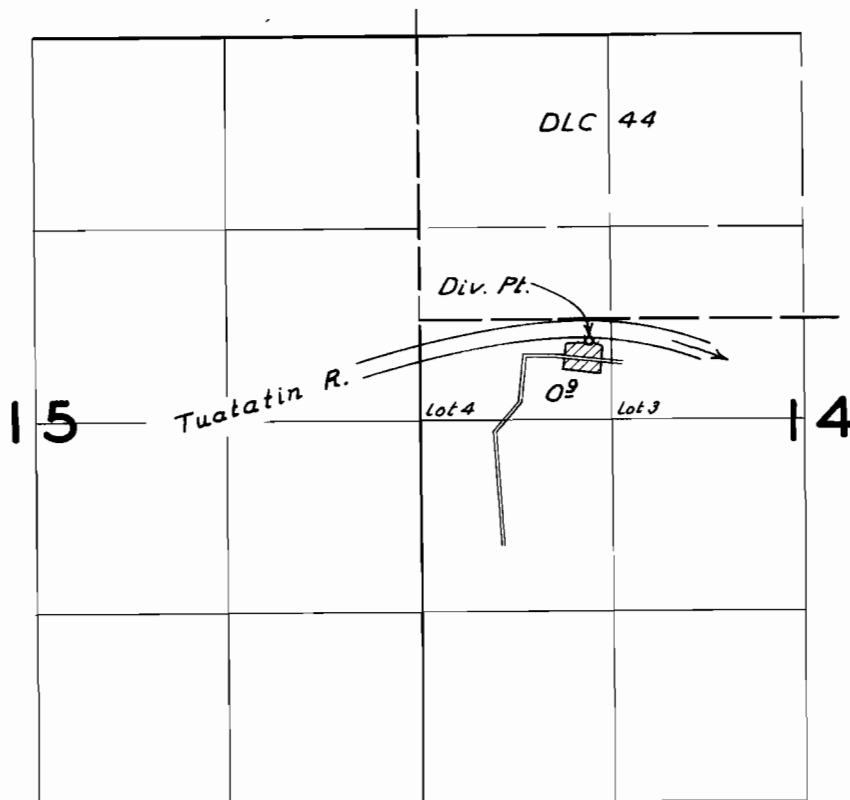

FINAL PROOF SURVEY
UNDER

Application No. 30900 ... Permit No. 24331 ...
IN NAME OF

Clarence L. & Ruby J. Smith

Surveyed *Sept. 14* 1959, by *C.O. Bartels*...