


T.38 S.R.5 W.W.M.

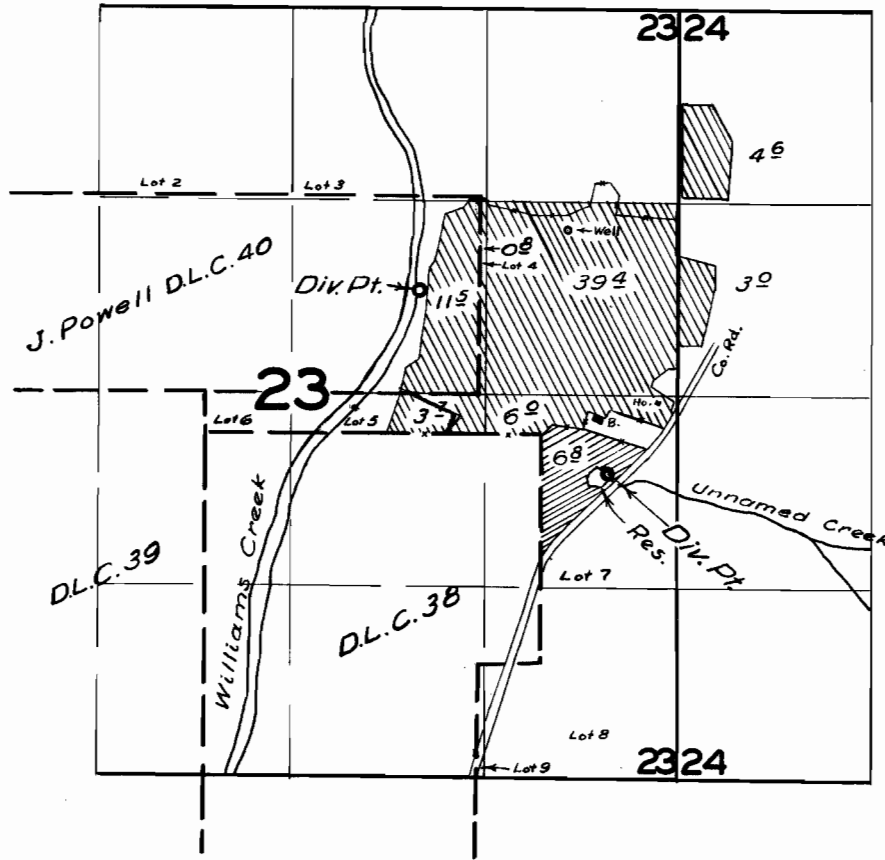

FINAL PROOF SURVEY UNDER

R-31030 R-1902
 30866 24368
 Application No. 31031 Permit No. 24594
 IN NAME OF

..... JOHN H. KATZENBACH

Surveyed 24 July 1959, by M. B. Bish