


T38 S., R5 W., W.M.
Scale 4"=1 mile June 1956
John H. Katzenbach.

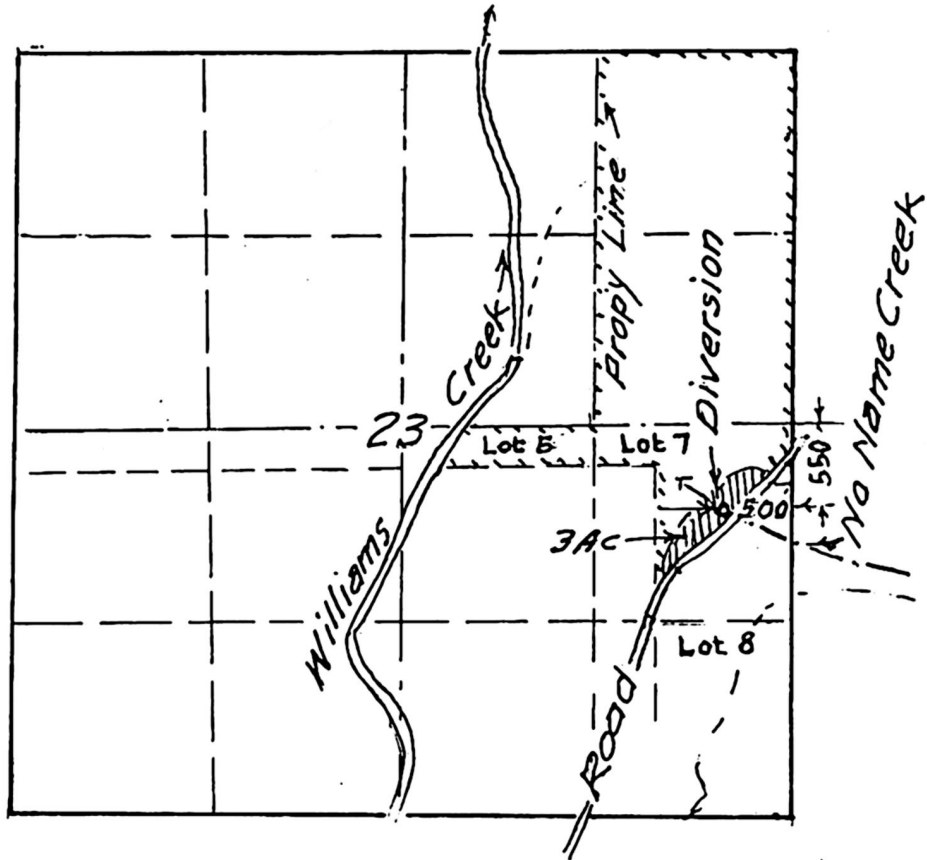

Application No. R-31030
30866
Permit No. R-1902
24368