


T.40 S.R.8 W.W.M.

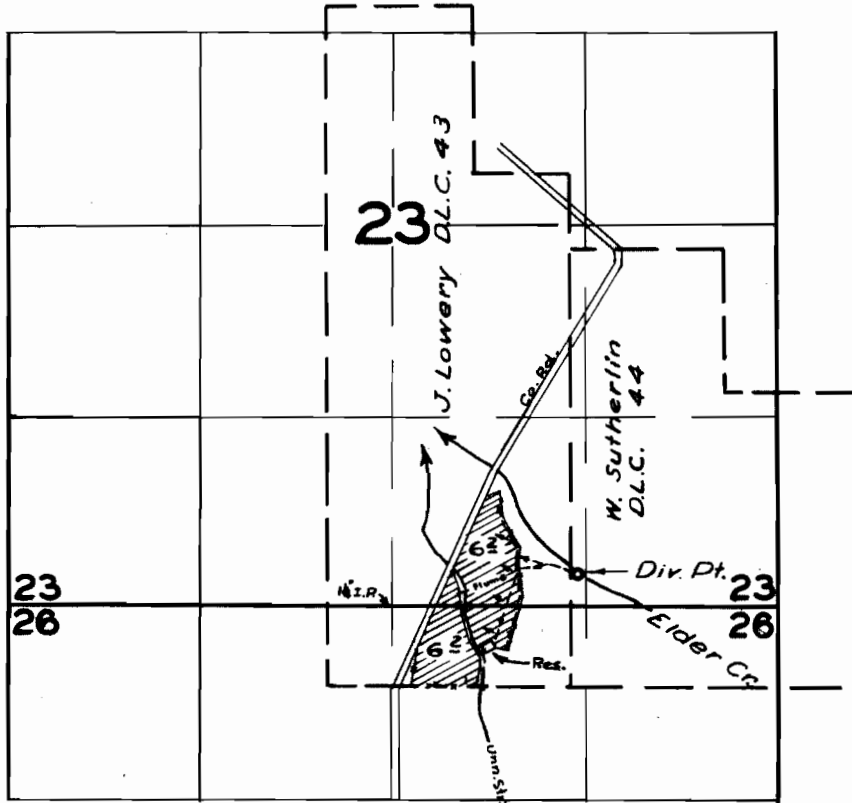

FINAL PROOF SURVEY UNDER

R 31066 R 1913
Application No. 31067 Permit No. 24424
IN NAME OF

MARY WILSON

Surveyed 16 July 1959, by M. A. Bish