


T. 10S. R. 2W. W.M.

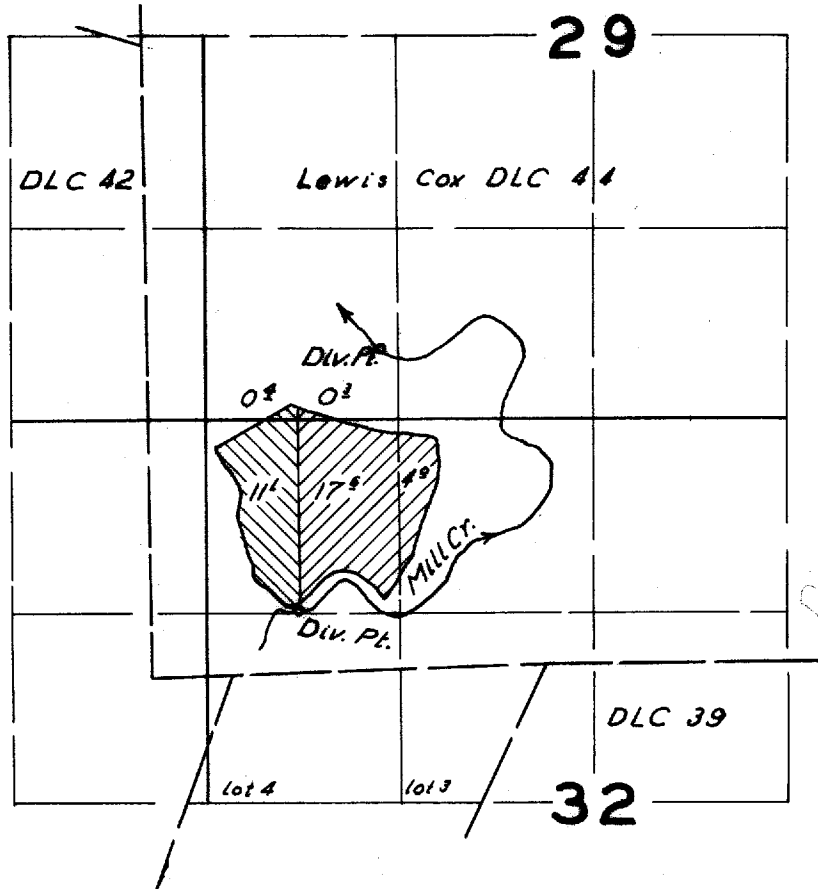

FINAL PROOF SURVEY

UNDER

Application No. 31432 Permit No. 24765

IN NAME OF

Lola May Roth

Surveyed Aug 25 19 59, by R. H. Jackson