


T. 24 S. R. 7 W. W. M.

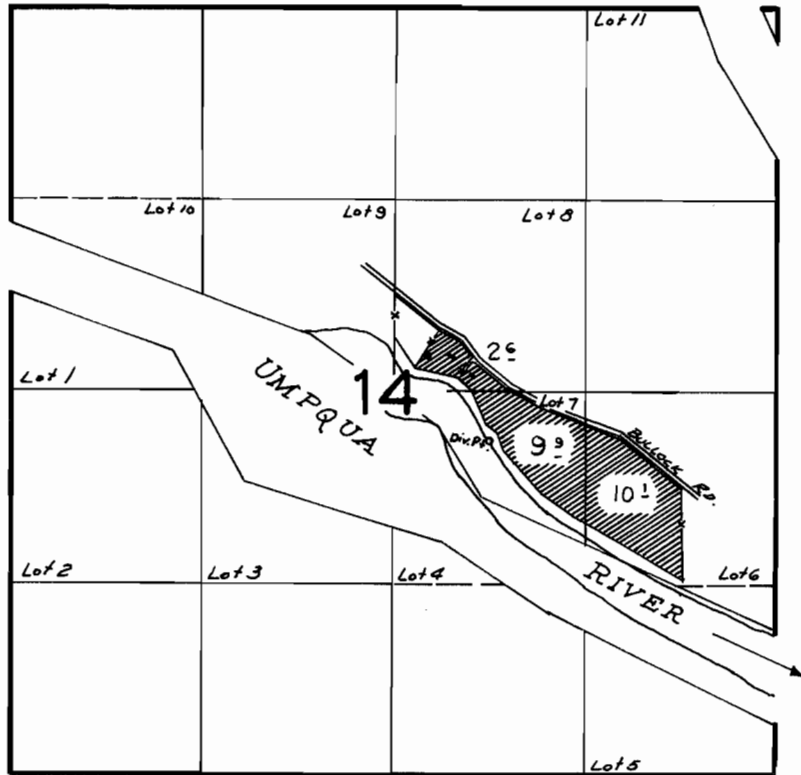

**FINAL PROOF SURVEY**  
UNDER

Application No. 31574 Permit No. 24913  
IN NAME OF

*FRANK & ROSE ASHLEY*

Surveyed June 16, 1959, by *R. Jackson*


10 11

SEC. 14 T24S R7W W.M.

11 12

15 14

14 13

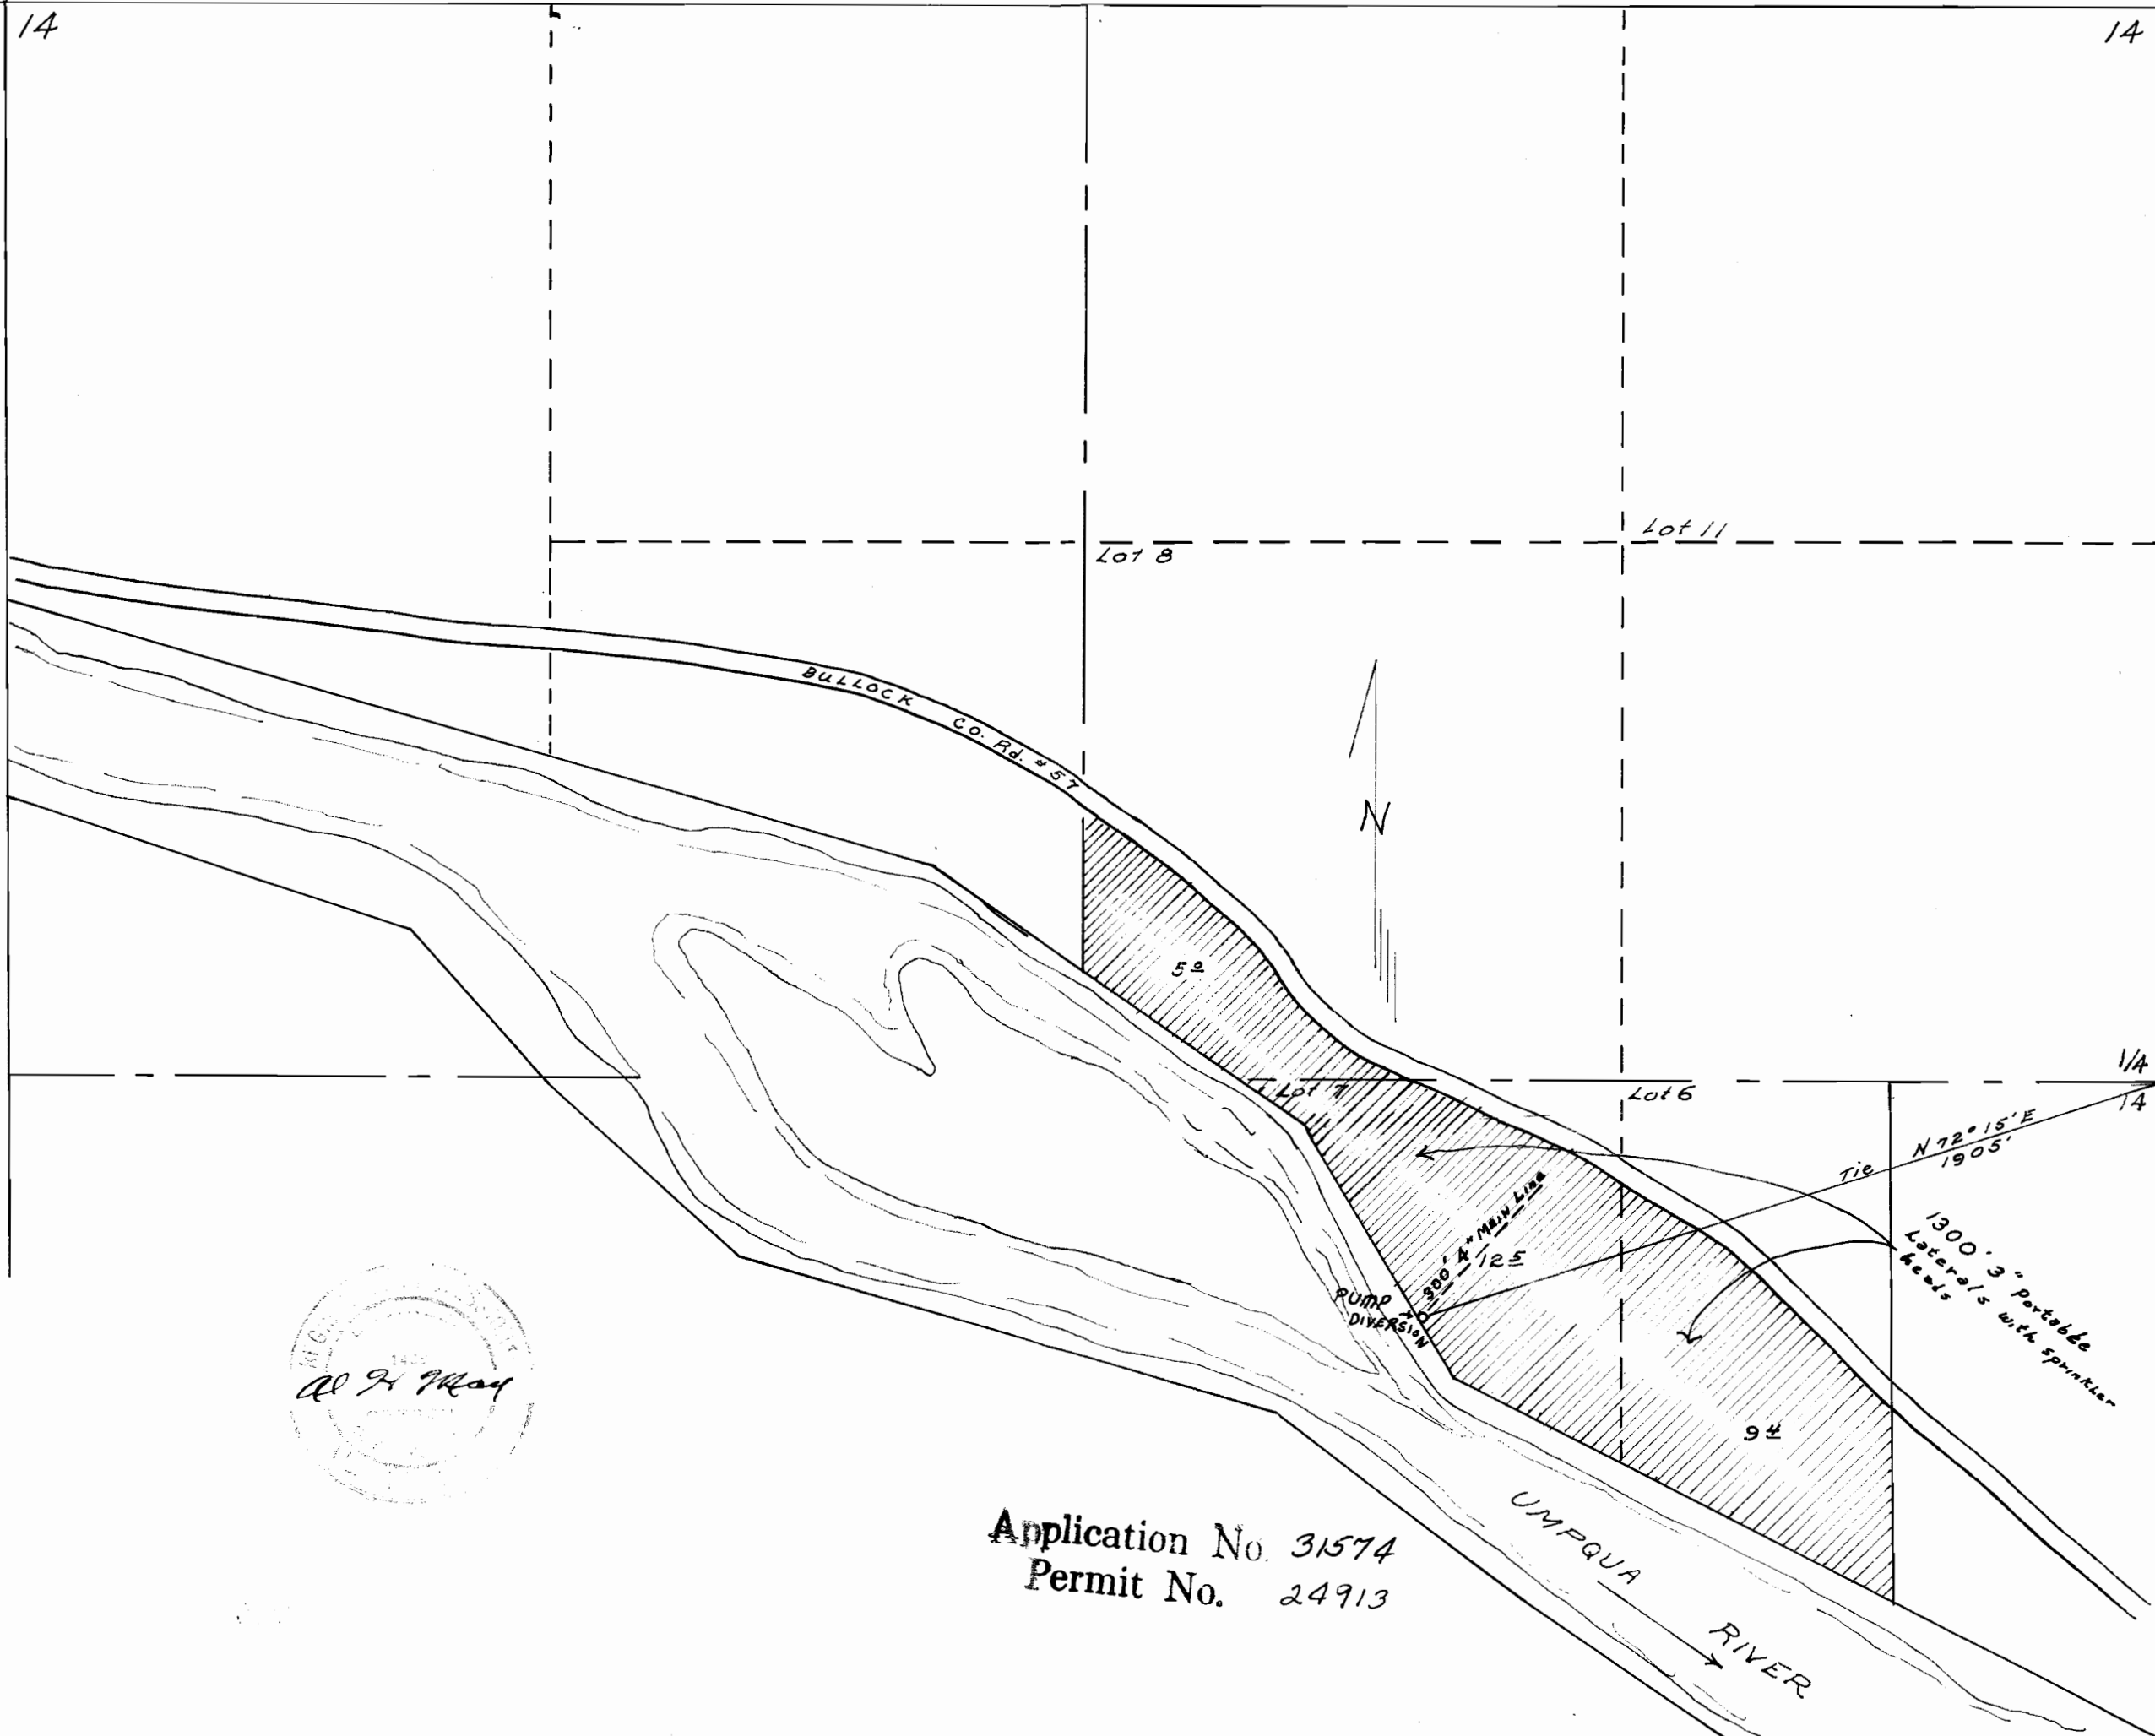

Application No. 31574  
 Permit No. 24913