


T.15S. R.46 E.W.M.

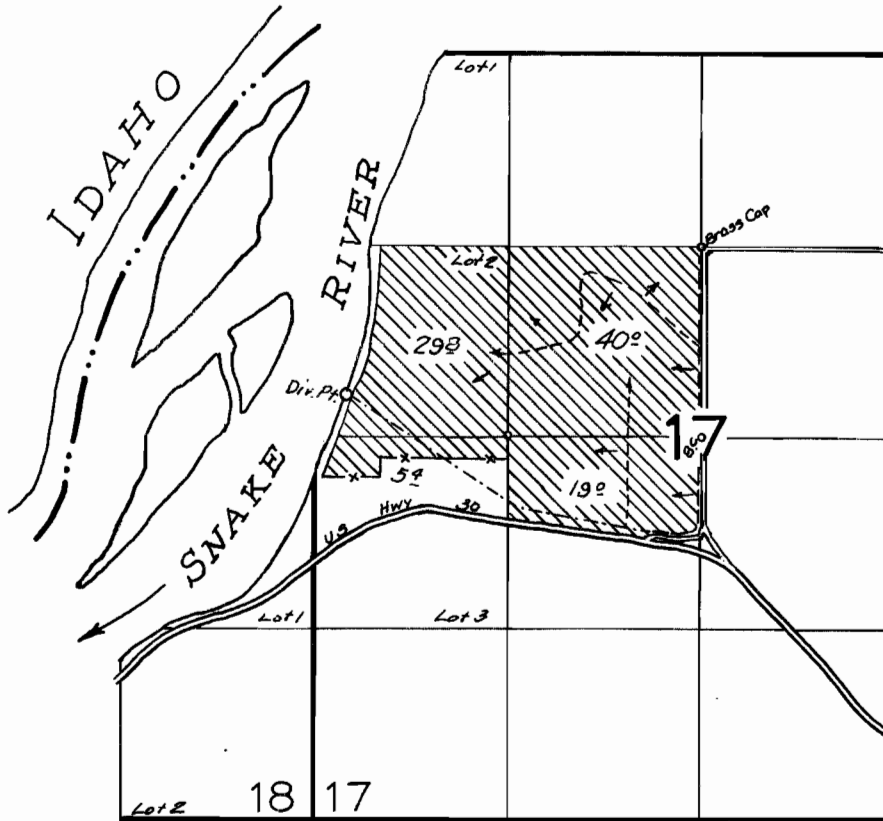

FINAL PROOF SURVEY

UNDER

Application No. 31449 Permit No. 25068

IN NAME OF

VIRGIL & MYRA J. WALKER

Surveyed Sept. 19 1959, by R. Jackson