


T.16S. R.47-48E.W.M.

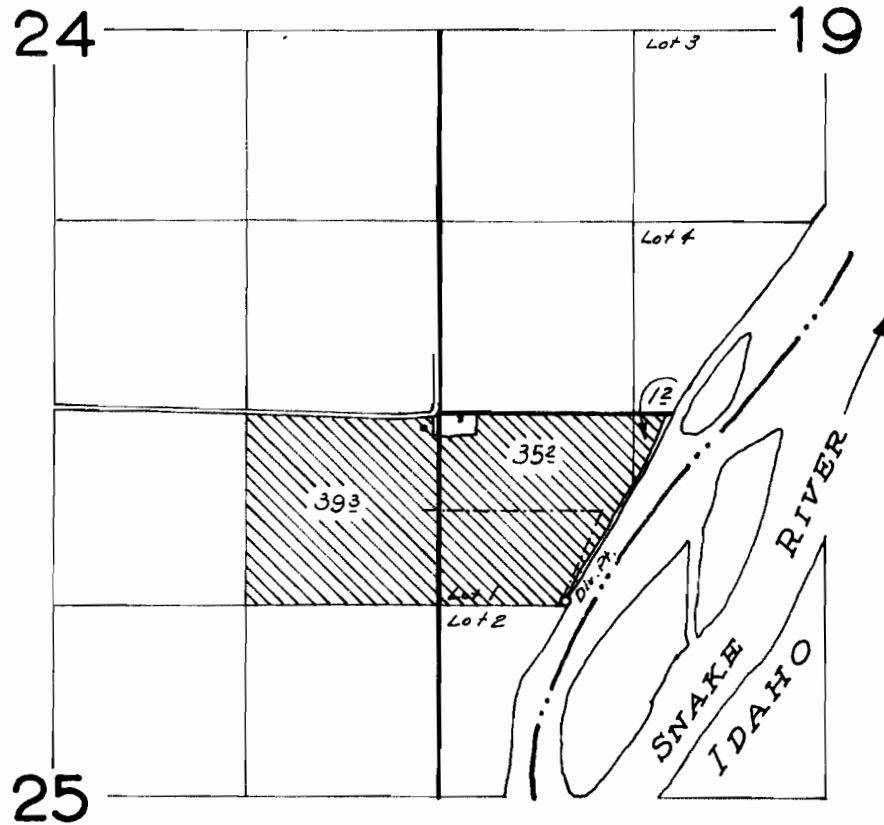

FINAL PROOF SURVEY

UNDER

Application No. 32591 Permit No. 25721

IN NAME OF

S. C. VANDENBURG

Surveyed Sept. 19 1959, by [Signature]