


T.39 S.R.8 W.W.M.

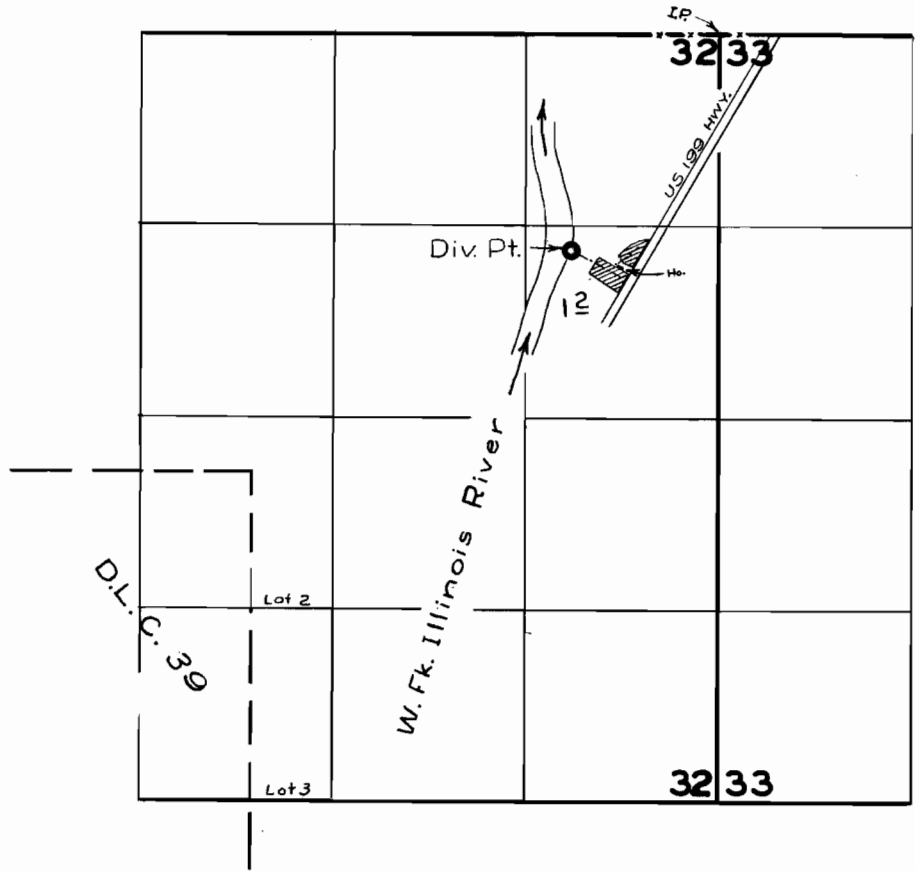

FINAL PROOF SURVEY
UNDER

Application No. 31818 Permit No. 25146
IN NAME OF

MELVIN L. & ARLEINE E. GRAY

Surveyed 17 July 1959, by M. Rich