


T. 3 S. R. 45 E. W.M.

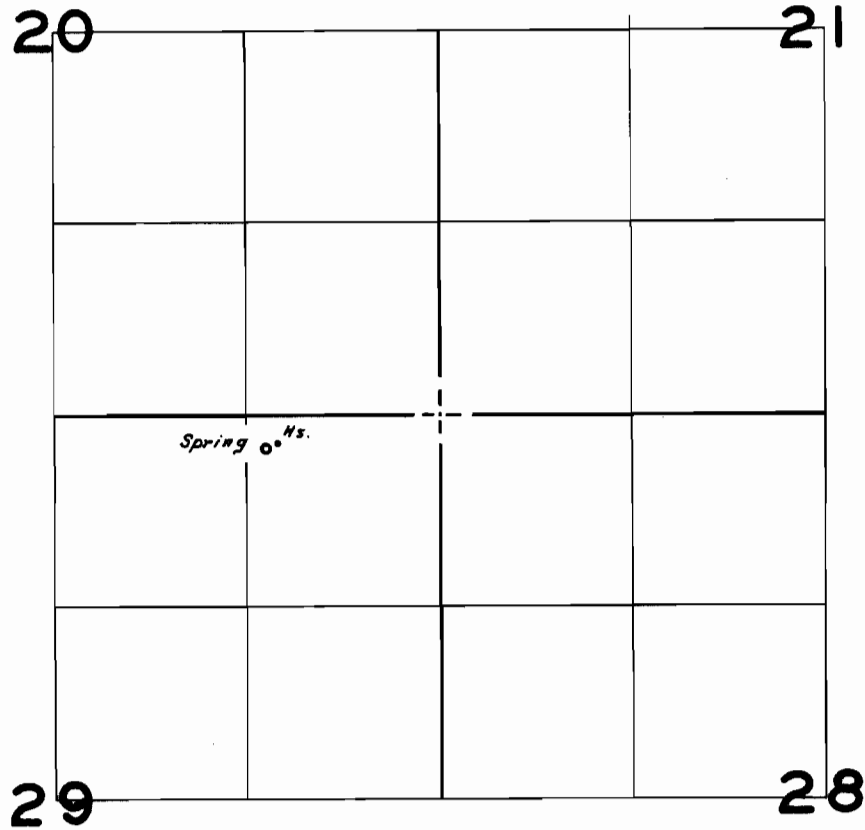

FINAL PROOF SURVEY
UNDER

Application No. 32737 Permit No. 25843
IN NAME OF

Marie Tiggelbeck

Surveyed Aug. 11, 1959, by R.H. Jackson