


T. 5N. R. 9W. W.M.

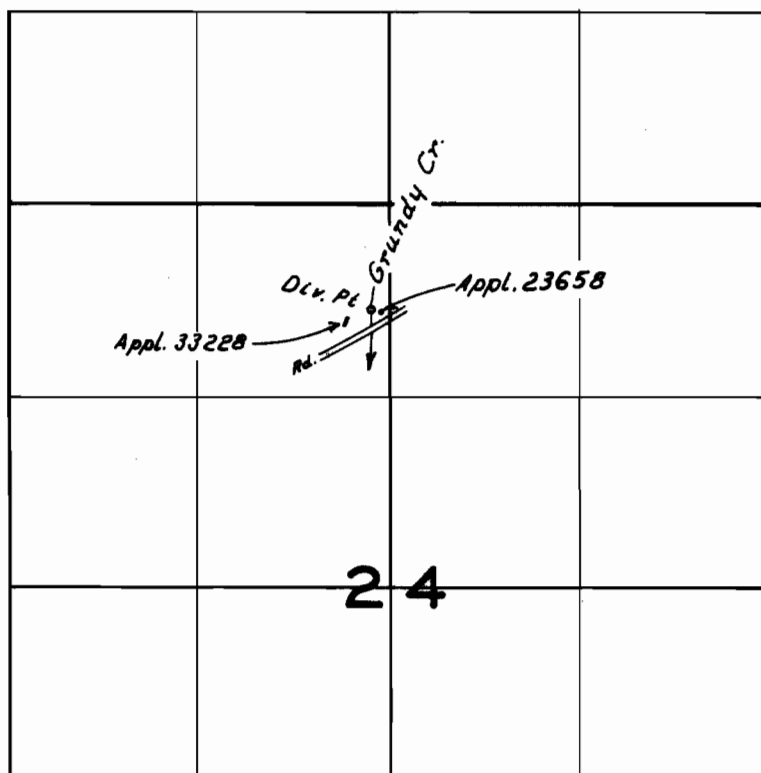

FINAL PROOF SURVEY
UNDER

Application No. ³³²²⁸ ~~23658~~ Permit No. ²⁶²⁸⁰ ~~18701~~
IN NAME OF

George & Donna Ordway

Surveyed June 30 1959, by G.O. Bartels