


T.28 S.R.46 E.W.M.

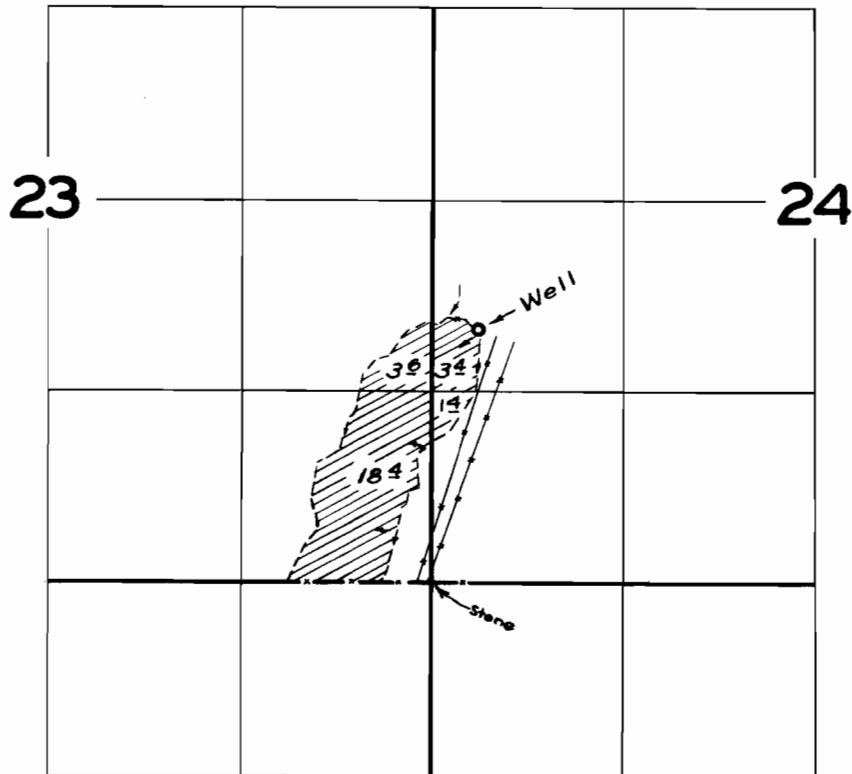

FINAL PROOF SURVEY
UNDER

Application No. G-164 Permit No. G-102
IN NAME OF

FRANK & MARY E. BALTZOR

Surveyed 21 Sept 1959, by M. Bish