


T. 27 S.R. 38 E.W.M.

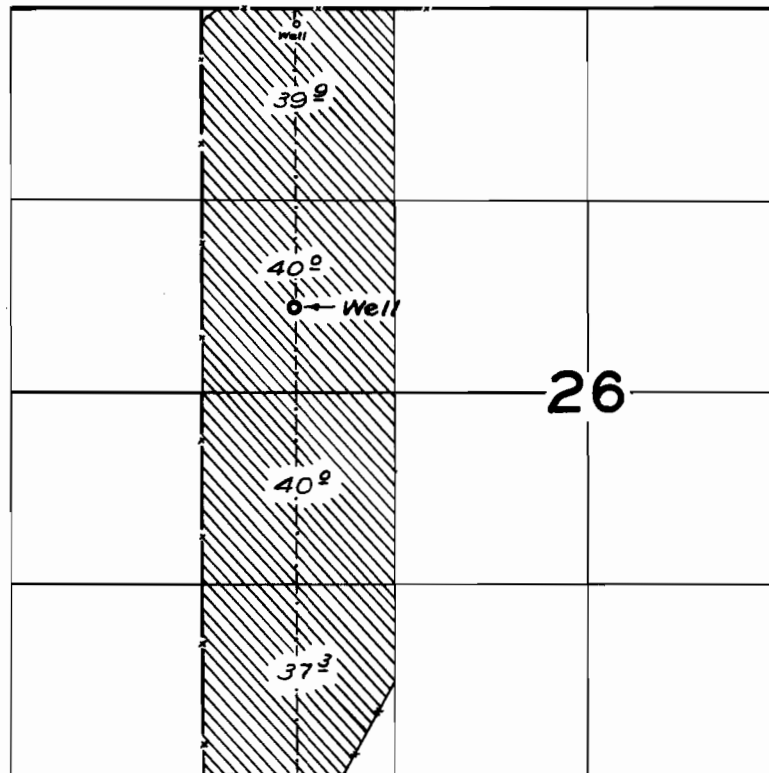

FINAL PROOF SURVEY

UNDER

Application No. G-188 Permit No. G-104

IN NAME OF

HAROLD C. HUTCHINSON

Surveyed 26 Sept 19 59, by M. B. S.