


T. 5S. R. 1W. W.M.

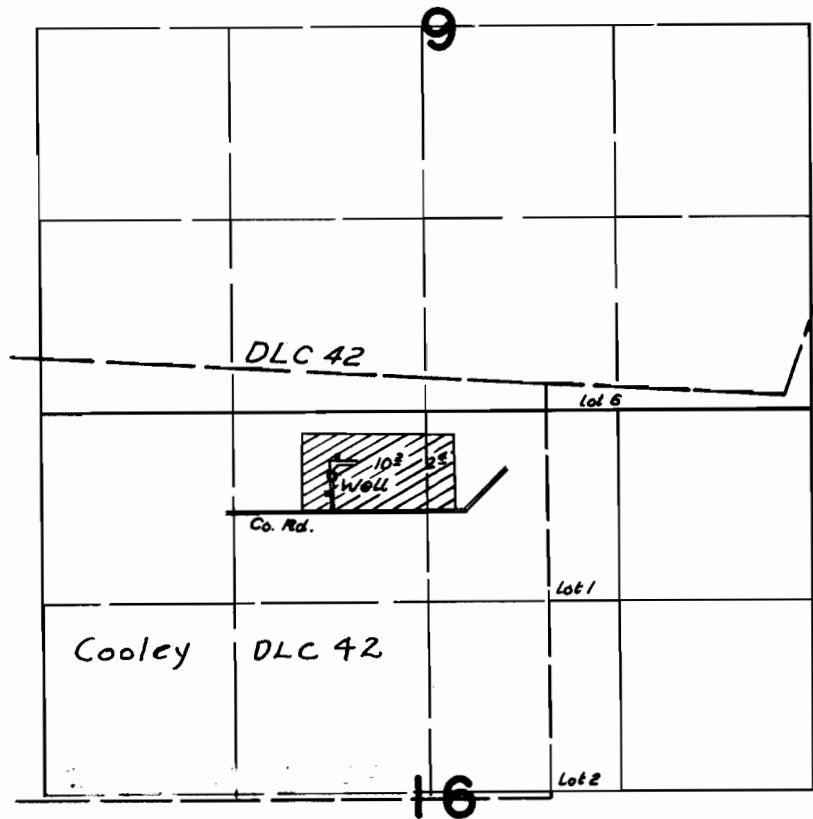

**FINAL PROOF SURVEY**  
UNDER

Application No. *G263* Permit No. *G170*  
IN NAME OF

*Yacov Konovalov*

Surveyed *May 21, 1959*, by *R.H. Jackson*