


T.38 S.R.11 1/2 E.W.M.


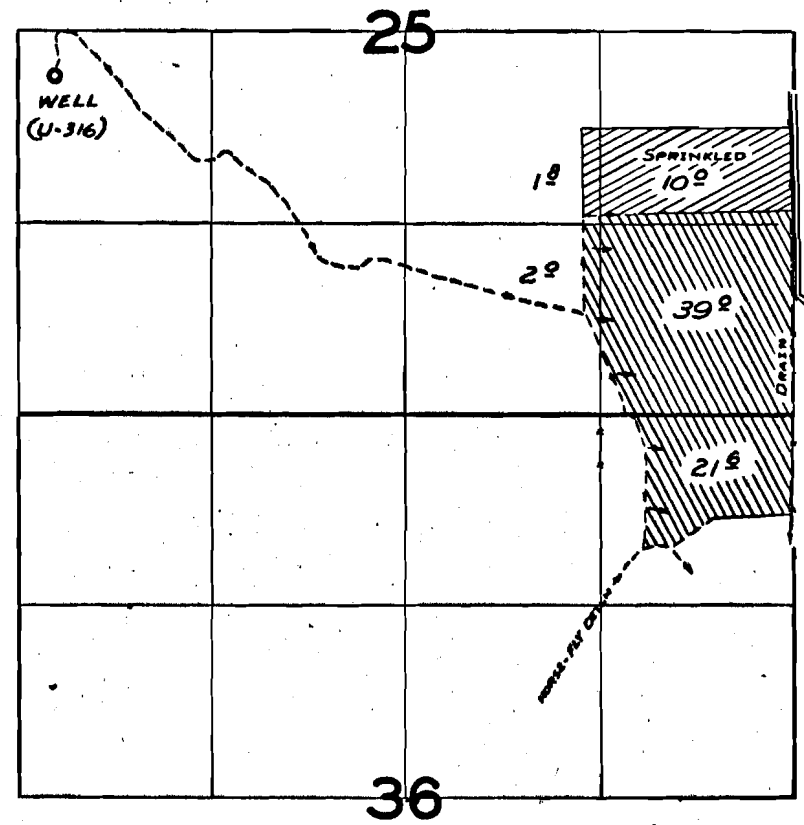

FINAL PROOF SURVEY

UNDER

Application No. G-14 Permit No. G-179

IN NAME OF

RICHARD HOEFLER

Surveyed 14 Oct. 1959, by M. Bish