


T. 4S. R. 2W.W.M.

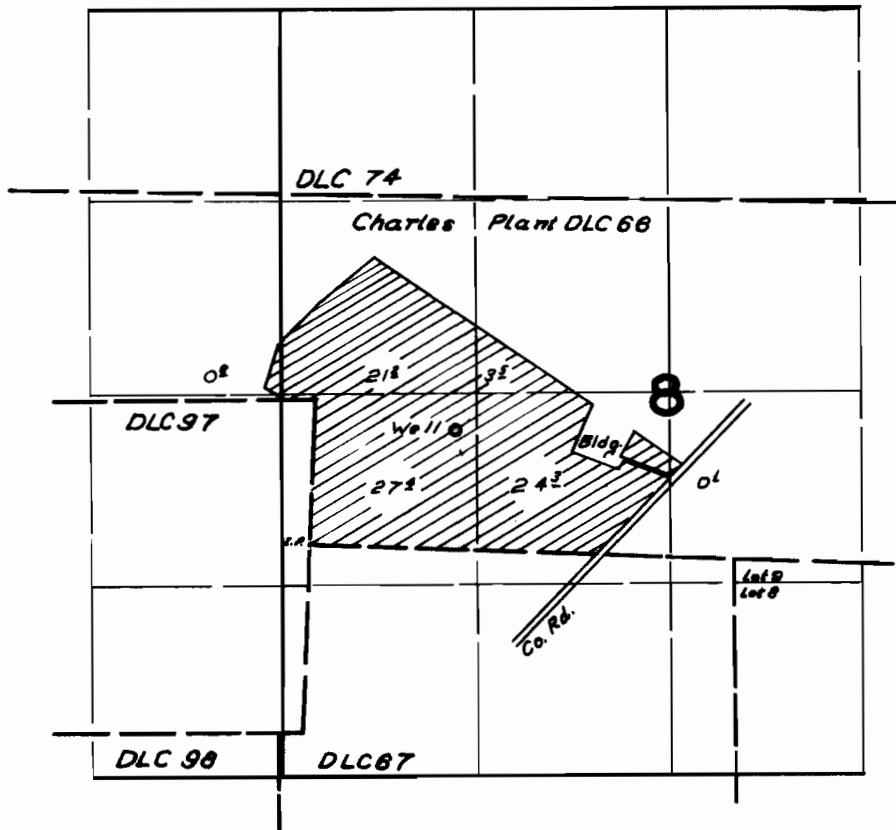

FINAL PROOF SURVEY UNDER

Application No. *G-414* Permit No. *G-288*
IN NAME OF

Milo Schneider

Surveyed *April 20 1959*, by *R.H. Jackson*