


T.36S. R.5W.W.M.

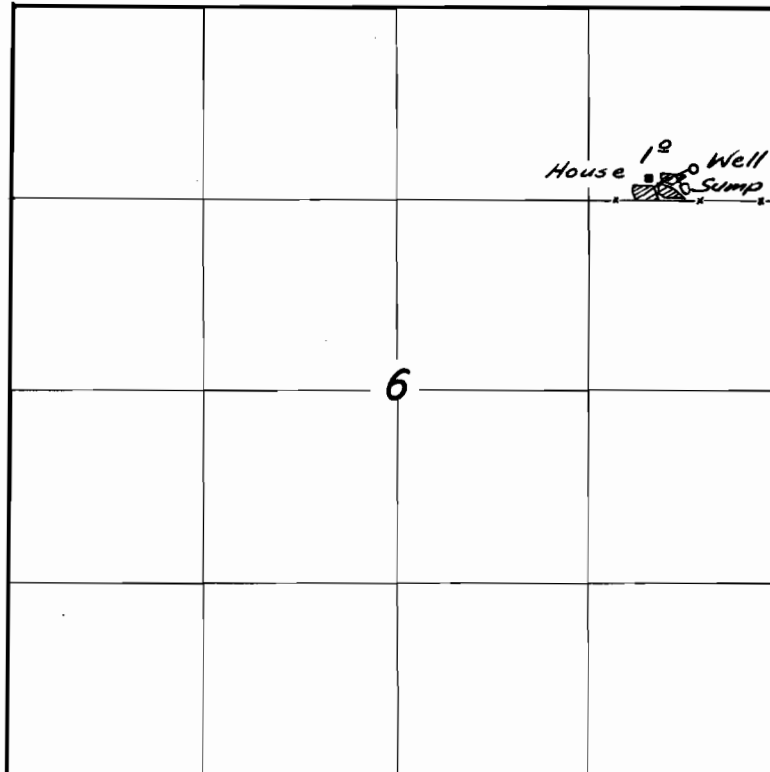

FINAL PROOF SURVEY

UNDER

Application No. G-512, Permit No. G-440

IN FAVOR OF

Ralph D. Shoulders

Surveyed July 13, 1959, by C.O. Baultel