


T.20 S.R.46 E.W.M.

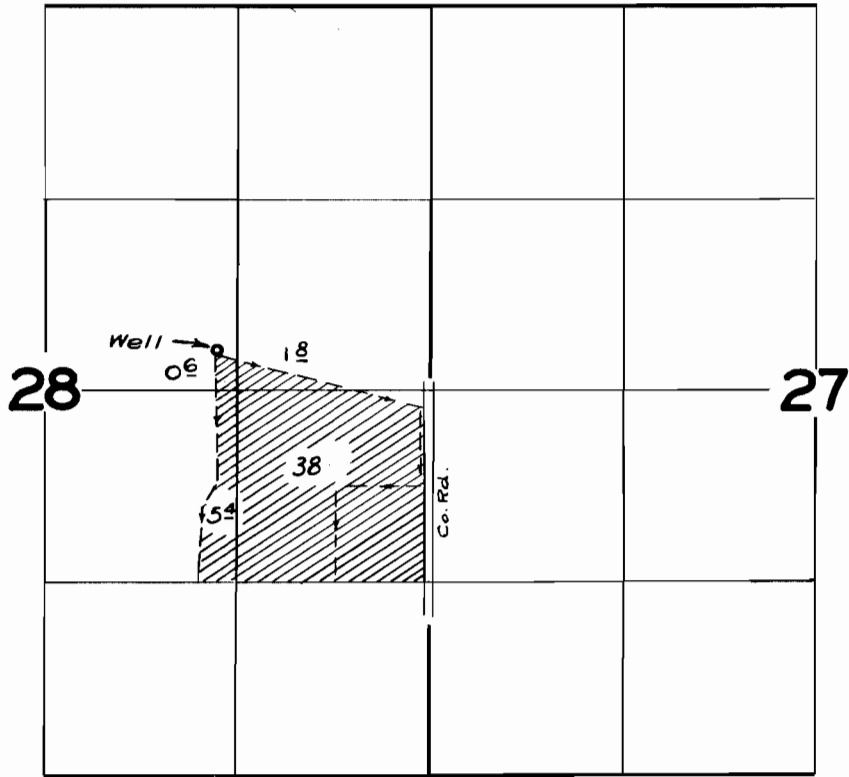

FINAL PROOF SURVEY
UNDER

Application No. G-546 Permit No. G-453
IN NAME OF

HENRIETTA & GEORGE MENDAZONA

Surveyed Sept. 16 1959, by m. Bich