


T.14 S.R.5 W.W.M.

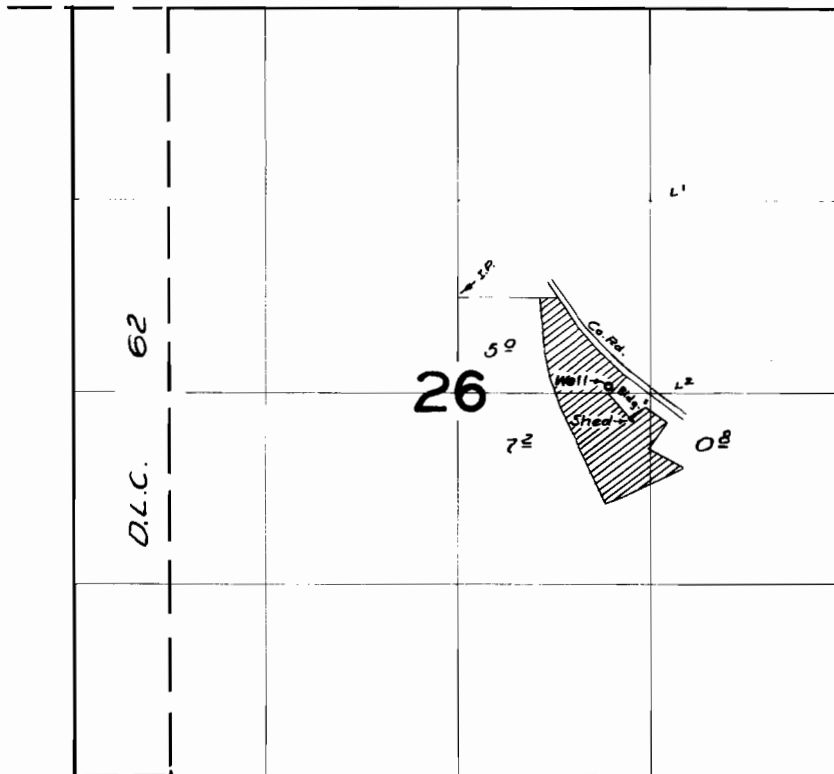

FINAL PROOF SURVEY UNDER

Application No. G-561 Permit No. G-473
IN NAME OF

A.A. WHEELER

Surveyed 11 Mar. 1959, by M. Bish