


T. 3S. R. 1E. W.M.

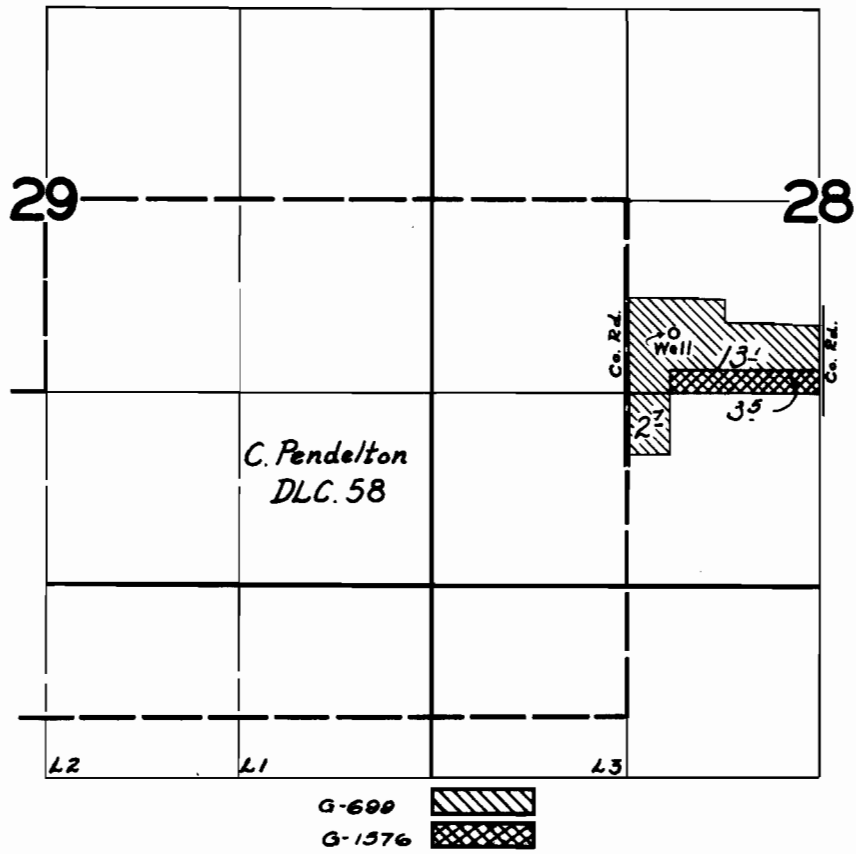

**FINAL PROOF SURVEY**  
UNDER

Application No. *G-1576* Permit No. *G-1437*  
*G-699* *G-600*  
IN NAME OF

*Tom & John R. Dodds*

Surveyed *Sept. 3* 1959, by *R. H. Jackson*