


T.19 S.R.47E.W.M.

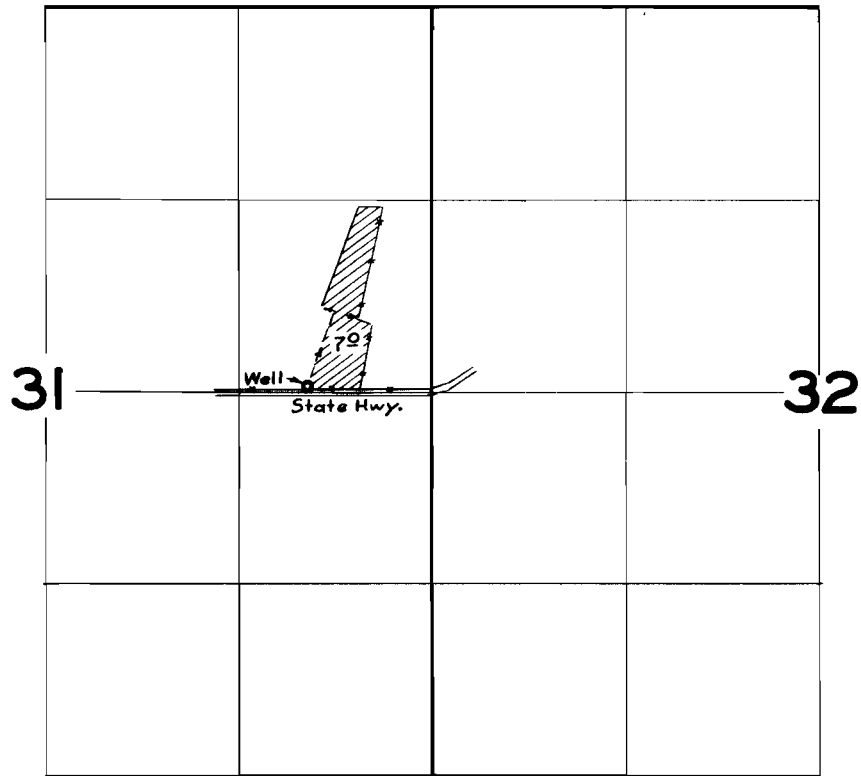

FINAL PROOF SURVEY UNDER

Application No. *G-1084* Permit No. *G-979*
IN NAME OF

FRANK W. SHERWOOD

Surveyed *15 Sept. 1959*, by *M. B. Sch*